

MISSISSIPPI DEPARTMENT OF NATURAL RESOURCES
Bureau of Land and Water Resources
 Southport Mall
 P.O. Box 10631
 Jackson, Mississippi 39209
WATER WELL DRILLERS LOG

Tipsh
B 2014
8-12-80

8-12-1980 date well completed Walton Well Co firm name Tipsh county well located

LANDOWNER:
C. F. Thorton
Rt 1 Walnut, Miss
 (mailing address)

description of fomations encountered	from	to
<u>Red Clay + Red Sand</u>	<u>0</u>	<u>30</u>
<u>Red Sand + Blue Clay</u>	<u>30</u>	<u>60</u>
<u>Blue Clay</u>	<u>60</u>	<u>135</u>
<u>Blue Clay + Rock</u>	<u>135</u>	<u>180</u>
<u>Blue Clay</u>	<u>180</u>	<u>195</u>
<u>Blue Clay + Brown Sand</u>	<u>195</u>	<u>210</u>
<u>Green Sand</u>	<u>210</u>	<u>225</u>

WELL LOCATION:
 sec. 31 T-1 N R-4E
6 miles South of Madala
 (distance) (direction) (nearest town)

WELL PURPOSE:
 (home, irrigation, municipal, industrial)

- WELL COMPLETION DATA:**
- diameter (inches) 4
 - total depth (feet) 220
 - static water level (feet) 145 below top of ground.
 - casing PVC 210
 (material) (depth)
 _____ if telescope see back.
 (size)
 - screen 10 215
 (length) (depth to top)

 (size) (material) gravel packed
 - pump 3/4 10
 (HP) (yield gpm)
electric
 (type power)
 - electric log (yes or no) _____


 (organization running log)
 - how well bottom plugged 4"
plastic cap

DRILLERS REMARKS:

DEPT. OF NATURAL RESOURCES
 BUREAU OF LAND & WATER RESOURCES
 SEP 29 1980
RECEIVED

If well telescopes please sketch and show depths.

GROUND LEVEL

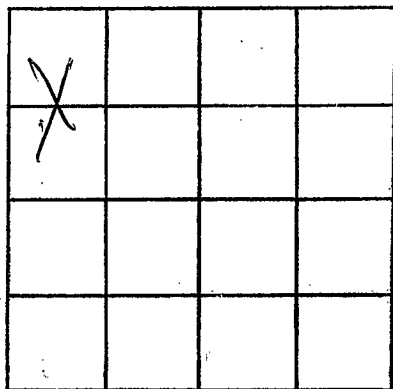

SECTION B31

Please indicate well location X.

ADDITIONAL INFORMATION

If more than one screen,
show locations of each on sketch.