

MISSISSIPPI DEPARTMENT OF ENVIRONMENTAL QUALITY

Office of Land and Water Resources
RECEIVED
 P. O. Box 0631
 Jackson, MS 39289-0631
 WATER WELL DRILLERS LOG

COUNTY WELL LOCATED
Supiah
 WELL NUMBER 5 2018 CODED
 DATE WELL COMPLETED
4/16/97

PERMIT NUMBER
 NAME OF DRILLING FIRM
Wilson Well Co

NAME & MAILING ADDRESS OF LANDOWNER
Manning Wood
PO Box 330
Walnut, Ms 38683
 WELL LOCATION: SEC 29 TOWNSHIP 1 N RANGE 4 E
 DISTANCE 5 Miles W of walnut
 OTHER LANDMARK
 WELL PURPOSE: Home, Irrigation, Municipal, Industrial, Fish Pond, etc.

PUMP DATA
 Dept. of Environmental Quality
 Office of Land & Water Resources
 PUMP TYPE (Circle One):
 Submersible, Tractor, Diesel, Gasoline, Butane, Other (Describe)
 POWER TYPE (Circle One):
 Electric, Tractor, Diesel, Gasoline, Butane, Other (Describe) H/P _____
 Pump Capacity (GPM) 10 No. of Stages _____ Setting Depth 80 FT.
 PUMP TEST
 Well yielded _____ GPM with
 a drawdown of _____ ft.
 after _____ hours of pumping

WELL DATA
 Well Depth 120 Casing Diameter (In.) 4 Casing Length (Ft.) 110
 Type of Casing PVC Hole Depth 120 Depth to Static Water Level 20
 TYPE OF COMPLETION: (Circle One or More):
 Gravel Packed, Underreamed, Telescoped,
 Natural Development, Open Hole, Other
 (Describe) _____
 WELL GROUTED TO A DEPTH OF _____ FEET
 Type Grout (circle one): Cement, Bentonite, or Mix

LOG DATA
 TYPE OF LOG RUN (Circle One): No Log Run, Electric, Gamma Ray, Density, Sonic, Neutron, Other (Describe) _____
 Name of Organization Running Log

SCREEN DATA
 Diameter - Inches 4 Length - Feet 10' Slot Size - Inches .010
 Screen Type PVC Depth to Bottom - Feet 120

GEOLOGIC DATA (Office Use Only)

| | | | |
|---------------|---------------|----------------|--------------|
| Surface Elev. | Geologic Unit | Unit Thickness | Depth to Top |
| Subs. SWL | Date | Analysis | Aquifer Test |

Driller's Remarks


 Top of Lap Pipe or Reduction in Casing
 FEET IF TELESKOPED OR MORE THAN ONE SCREEN: USE BACK PAGE

| DESCRIPTION OF FORMATIONS ENCOUNTERED | FROM | TO | FORMATIONS (Continued) | FROM | TO |
|---------------------------------------|------|-----|------------------------|------|----|
| Red clay | 0 | 5 | | | |
| white sand | 5 | 35 | | | |
| Rock | 35 | 37 | | | |
| Grey clay | 37 | 90 | | | |
| white sand | 96 | 97 | | | |
| Grey clay | 97 | 100 | | | |
| white sand | 100 | 118 | | | |
| Grey clay | 118 | 120 | | | |
| | | | | | |
| | | | | | |
| | | | | | |

IF MORE SPACE IS NEEDED, USE BACK

If well telescopes please
sketch and show depths.

GROUND LEVEL

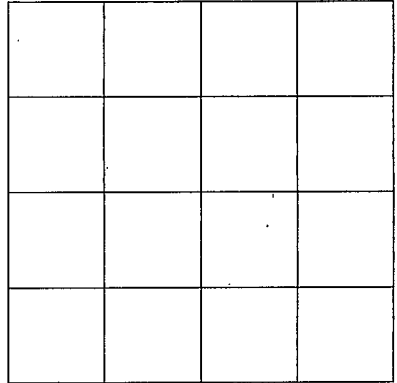

SECTION _____

Please indicate well location X.

ADDITIONAL INFORMATION

If more than one screen,
show location of each on sketch.