

Lippach
C5
3-9-68

MISSISSIPPI
 BOARD OF WATER COMMISSIONERS
 416 North State Street
 Jackson, Mississippi 39201

CODED

WATER WELL DRILLERS LOG

3-9-1968 date well completed Jumper Well Co firm name Lippach county well located

LANDOWNER:
O. L. Todd
Walnut Miss
 (mailing address)

description of formations encountered	from	to
<u>Misc. Clay</u>	<u>0</u>	<u>130</u>
<u>Rock + Sand</u>	<u>130</u>	<u>180</u>

WELL LOCATION:
 sec. 11 T. 2 N. R. 3 E
4 miles W. of Walnut
 (distance) (direction) (nearest town)

WELL PURPOSE: Home
 (home, irrigation, municipal, industrial)

- WELL COMPLETION DATA:
- (1) diameter (inches) 4
 - (2) total depth (feet) 180
 - (3) static water level (feet) 100 below above top of ground.
 - (4) casing PVC, 140,
 (material) (depth)
4" if telescope see back.
 (size)
 - (5) screen 40, 140
 (length) (depth to top)
4", PVC
 (size) (material)
 - (6) pump 1 1/2, 8
 (HP) (yield gpm)
Elect
 (type power)
 - (7) electric log NO
 (yes or no)
0
 (organization running log)
 - (8) how well bottom plugged PVC Cap

CODED

DEC 10 1968


DRILLERS REMARKS:

MISS. Bd. OF
 WATER COMMISSIONERS

If well telescopes please sketch and show depths.

GROUND LEVEL

Casing 140 ft
Screen 40 ft
Batter 180 ft

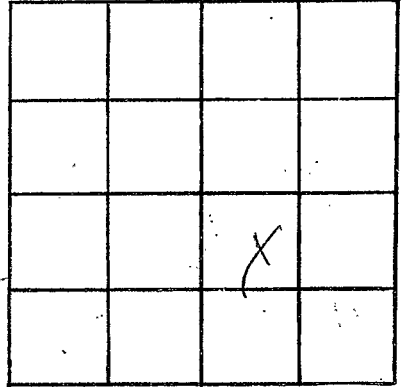

SECTION 11

Please indicate well location X.

ADDITIONAL INFORMATION

If more than one screen, show locations of each on sketch.