

TIPPAH
 C 7
 3-24-69

MISSISSIPPI
 BOARD OF WATER COMMISSIONERS
 416 North State Street
 Jackson, Mississippi 39201

CODED

WATER WELL DRILLERS LOG

3-24-69 19 June Well Co - Tippah
 date well completed firm name county/well located

LANDOWNER:

Jay Rucker
Jay Rucker
 (mailing address)

description of formations encountered

from to

<u>Sand + Clay</u>	<u>0</u>	<u>100</u>
<u>Clay</u>	<u>100</u>	<u>200</u>
<u>Sand + Rock</u>	<u>200</u>	<u>350</u>

WELL LOCATION:

sec 23 T 2 N R 3 E
5 miles W of Tippah
 (distance) (direction) (nearest town)

WELL PURPOSE: Home
 (home, irrigation, municipal, industrial)

WELL COMPLETION DATA:

- (1) diameter (inches) 4"
- (2) total depth (feet) 350
- (3) static water level (feet) 140 below top of ground.
- (4) casing PVC, 150,
 (material) (depth)
4" if telescope see back.
 (size)
- (5) screen 0, 0
 (length) (depth to top)
0, 0
 (size) (material)
- (6) pump 1 1/2, 7
 (HP) (yield gpm)
Elec
 (type power)
- (7) electric log No
 (yes or no)

(organization running log)

(8) how well bottom plugged 0

DRILLERS REMARKS:


INLAND

FEB 18 1970

MISS. BD. OF
 WATER COMM.

If well telescopes please sketch and show depths.

GROUND LEVEL

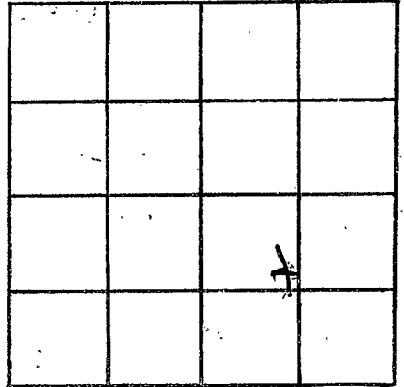

SECTION 23

Please indicate well location X.

ADDITIONAL INFORMATION

If more than one screen,
show locations of each on sketch.