

MISSISSIPPI
BOARD OF WATER COMMISSIONERS
416 North State Street
Jackson, Mississippi 39201

INDEXED

WATER WELL DRILLERS LOG

8-4-69 19 Jump Well Co. Jipah
date well completed firm name county well located

LANDOWNER:

Vera Oyes Prather
Ospreyville, Miss
(mailing address)

description of formations encountered.

from to

<u>Snd + Clay</u>	<u>0</u>	<u>100</u>
<u>Clay</u>	<u>100</u>	<u>200</u>
<u>Snd + Rock</u>	<u>200</u>	<u>350</u>

WELL LOCATION:

sec 23 T. 2 R. 3 E
S 5 W. Ospreyville
(distance) (direction) (nearest town)

WELL PURPOSE:

Home
(home, irrigation, municipal, industrial)

WELL COMPLETION DATA:

- diameter (inches) 4"
- total depth (feet) 350 ft.
- static water level (feet) 140 below top of ground.
- casing PVC 150
(material) (depth)
4" if telescope see back.
(size)
- screen 0 0
(length) (depth to top)
0 0
(size) (material)
- pump 1/2 7
(HP) (yield gpm)
Elec.
(type power)
- electric log No
(yes or no)
0
(organization running log)
- how well bottom plugged 0


DRILLERS REMARKS:

FEB 18 1970

MISS. BD. OF
WATER COMM.

If well telescopes please sketch and show depths.

GROUND LEVEL

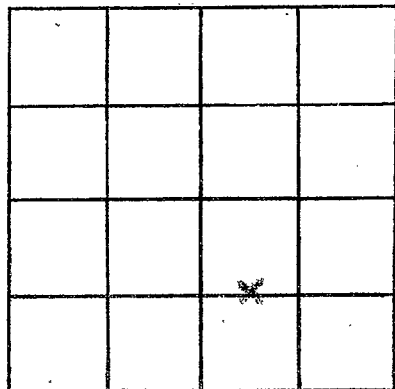

SECTION 23

Please indicate well location X.

ADDITIONAL INFORMATION

If more than one screen, show locations of each on sketch.