

Tippah  
C 10

MISSISSIPPI  
BOARD OF WATER COMMISSIONERS  
416 North State Street  
Jackson, Mississippi 39201

CODE

7/3/70  
7/8/70

WATER WELL DRILLERS LOG

J. T. Medlin

Tippah

06-1 19 70  
date well completed

firm name

county well located

LANDOWNER: J. H. Balch

Ripley, Miss

(mailing address)

WELL LOCATION:

sec 29 T 2 N R 3 E  
6 miles W of Jolpha  
(distance) (direction) (nearest town)

WELL PURPOSE:

(home, irrigation, municipal, industrial)

WELL COMPLETION DATA:

- (1) diameter (inches) 4
- (2) total depth (feet) 473
- (3) static water level (feet) \_\_\_\_\_ below above top of ground.
- (4) casing F 246 (material) (depth)
- \_\_\_\_\_ if telescope see back.
- (5) screen None (length) (depth to top)
- \_\_\_\_\_ (size) (material)
- (6) pump 1/2 (HP) 0 (yield gpm)
- \_\_\_\_\_ (type power)
- (7) electric log \_\_\_\_\_ (yes or no)
- \_\_\_\_\_ (organization running log)
- (8) how well bottom plugged \_\_\_\_\_

description of formations encountered

from to

R Clay	0	8
Red Sand	8	13
Red Clay	12	17
" Sand	17	35
White Clay	35	16.5
Blue "	16.5	32.5
Blue Rock & gravel	32.5	320
Blue	320	345
Rock	345	352
Sand & Rock	352	379
Blue	379	398
Sand & Rock	398	473

CODED

JUL 1 1970


MISS. BD. OF  
WATER COMMISSIONERS

DRILLERS REMARKS:

This well no good - muddied wrong log

If well telescopes please sketch and show depths.

GROUND LEVEL

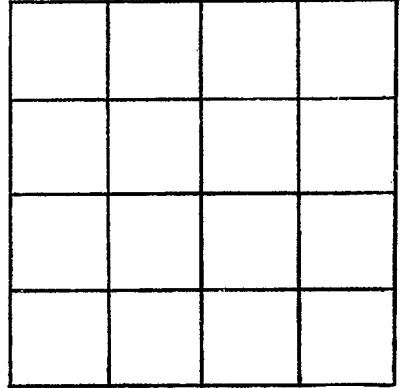

SECTION \_\_\_\_\_

Please indicate well location X.

ADDITIONAL INFORMATION

If more than one screen, show locations of each on sketch.