

TIPPAH  
 C 11  
 12-29-70

MISSISSIPPI  
 BOARD OF WATER COMMISSIONERS  
 416 North State Street  
 Jackson, Mississippi 39201

**CODED**

WATER WELL DRILLERS LOG

12-29-70 date well completed      Robert W. Wilson firm name      Tippah county well located

LANDOWNER: Roy Edgeston  
 TIGERSVILLE  
 Miss.  
 (mailing address)

description of formations encountered	from	to
Red Clay yellow sand blue clay	0	20
Blue Clay	20	180
Rock Blue Clay	180	200
Blue Clay	200	210
Brown Sand	210	232

WELL LOCATION:  
 sec. 24 T 2 N R 3 E  
 (distance) miles (direction) of (nearest town)

WELL PURPOSE:  
 (home, irrigation, municipal, industrial)

- WELL COMPLETION DATA:
- (1) diameter (inches) 4
  - (2) total depth (feet) 232
  - (3) static water level (feet) 180 below top of ground.
  - (4) casing 4 (material) 220 (depth)  
4 if telescope see back. (size)
  - (5) screen 12 (length) 220 (depth to top)  
4 (size) GRAVEL PACK (material)
  - (6) pump 3/4 (HP) 10 (yield gpm)  
Electric (type power)
  - (7) electric log  (yes or no)
- (organization running log)

**CODED**

(8) how well bottom plugged 4"  
plastic cap


JAN 26 1971

DRILLERS REMARKS:

MADE BY  
 WATER COMM.

If well telescopes please sketch and show depths.

GROUND LEVEL

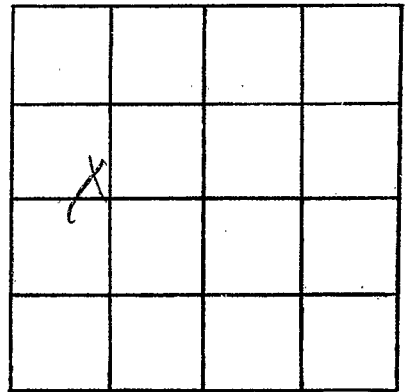

SECTION \_\_\_\_\_

Please indicate well location X.

ADDITIONAL INFORMATION

If more than one screen,  
show locations of each on sketch.