

MISSISSIPPI
BOARD OF WATER COMMISSIONERS
416 North State Street
Jackson, Mississippi 39201

CODED

Rm 414/7

WATER WELL DRILLERS LOG

TIPPDAH
C 13
3-13-71

3-13 1971 JT Meekin TippDAH
date well completed firm name county well located

LANDOWNER: CHARLIE
PATEN
WALNUT MS
(mailing address)

description of formations encountered	from	to
Red Clay	0	8
Blue "	8	170
Rock	170	209
sand	209	219
Blue "	219	228
sand	228	270

WELL LOCATION:
sec. 11 T 2 N R 3 E
4 miles W of Tupero, MS
(distance) (direction) (nearest town)

WELL PURPOSE:
(home, irrigation, municipal, industrial)

WELL COMPLETION DATA:

(1) diameter (inches) 4

(2) total depth (feet) 270

(3) static water level (feet) 90 below top of ground.

(4) casing P 270 (material) (depth)

(size) if telescope see back.

(5) screen 20 250 (length) (depth to top)

4 P (size) (material)

(6) pump 10 5 (HP) (yield gpm)

E (type power)

(7) electric log (yes or no)

(organization running log)

(8) how well bottom plugged 4" plug

? DINE R

CODED


APR 6 1971

DRILLERS REMARKS:

MISS. BU. OF
WATER COMMISSIONERS

If well telescopes please sketch and show depths.

GROUND LEVEL

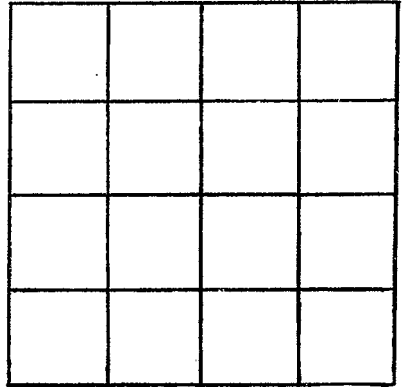

SECTION _____

Please indicate well location X.

ADDITIONAL INFORMATION

If more than one screen,
show locations of each on sketch.