

TIPPAH
C 17
4-24-72

MISSISSIPPI
BOARD OF WATER COMMISSIONERS
416 North State Street
Jackson, Mississippi 39201

CODED

WATER WELL DRILLERS LOG

4-24-72 date well completed
1972 Jungers Well Drilling firm name
Tippah county well located

LANDOWNER: Archie D. Mays
Rt 2 - Walnut Miss (mailing address)

description of formations encountered	from	to
mix of clay	0	130

WELL LOCATION:
sec. 11 T. 2 N. R. 3 E
4 miles (distance) W of Walnut (direction) (nearest town)

rock sand	130	180
-----------	-----	-----

WELL PURPOSE: Home
(home, irrigation, municipal, industrial)

- WELL COMPLETION DATA:
- (1) diameter (inches) 4"
 - (2) total depth (feet) 180
 - (3) static water level (feet) 100 below top of ground.
 - (4) casing PVC 170 (material) (depth)
4" (size) If telescope see back.
 - (5) screen 40 140 (length) (depth to top)
4" (size) PVC (material)
 - (6) pump 1 1/2 8 (HP) (yield gpm)
 - Elec (type power)
 - (7) electric log No (yes or no)
 - (organization running log)
 - (8) how well bottom plugged PVC
Cop

CODED

DEC 11 2012

MISSISSIPPI
WATER COMMISSION

DRILLERS REMARKS:

If well telescopes please sketch and show depths.

GROUND LEVEL

Casing


140 ft

Screen

40 ft.

Ballin

180 ft

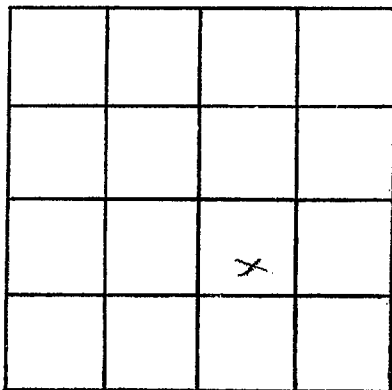

SECTION 11

Please indicate well location X.

ADDITIONAL INFORMATION

Lined area for additional information.

If more than one screen, show locations of each on sketch.