

TIPPAH  
C 20  
4-8-73

MISSISSIPPI  
BOARD OF WATER COMMISSIONERS  
416 North State Street  
Jackson, Mississippi 39201

CODED 900.00  
Net 45.00  
945.00

WATER WELL DRILLERS LOG

48  
date well completed

19 73 J T Medlin  
firm name

Tippah  
county well located

LANDOWNER:	description of fomations encountered	from	to
Terry Johnson Falkner (mailing address)			
WELL LOCATION:			
sec. 33 2 N R 3 E 6 miles W of Falkner (distance) (direction) (nearest town)			
WELL PURPOSE: (home, irrigation, municipal, industrial)			
WELL COMPLETION DATA:			
(1) diameter (inches) 4			
(2) total depth (feet) 180			
(3) static water level (feet) 140 below top of ground.			
(4) casing P 170 (material) (depth)			
(size) if telescope see back.			
(5) screen 10 170 (length) (depth to top)			
4 P (size) (material)			
(6) pump 5 6 (HP) (yield gpm)			
E (type power)			
(7) electric log _____ (yes or no)			
(organization running log)			
(8) how well bottom plugged Cap			
DRILLERS REMARKS:			


CODED

MAY 11 1973

MISS. Bd. OF  
WATER COMMISSIONERS

If well telescopes please  
sketch and show depths.

GROUND LEVEL

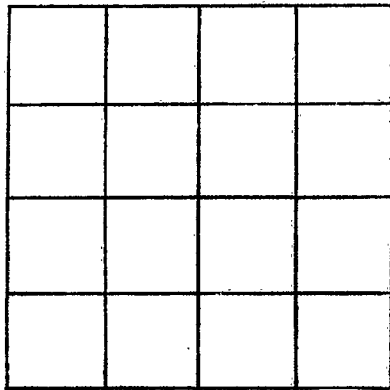

SECTION \_\_\_\_\_

Please indicate well location X.

ADDITIONAL INFORMATION

If more than one screen,  
show locations of each on sketch.