

TIPPAH
C 21
4-26-73

MISSISSIPPI
BOARD OF WATER COMMISSIONERS
416 North State Street
Jackson, Mississippi 39201

WATER WELL DRILLERS LOG

CODED

4-26-73 date well completed
1973 Jumper Well Drilling firm name
Tippha county well located

LANDOWNER:	description of formations encountered	from	to
LARRY W. Lbanks Tiptonsville, Miss (mailing address)	SAND & CLAY CLAY	0 100	100 200
WELL LOCATION: sec 23 T 2 N R 3 E 5 miles W of Tiptonsville (distance) (direction) (nearest town)	SAND & Rock	200	350
WELL PURPOSE: (home, irrigation, municipal, industrial) Home			
WELL COMPLETION DATA:			
(1) diameter (inches) 4"			
(2) total depth (feet) 350			
(3) static water level (feet) 140 below top of ground.			
(4) casing PVC 150 (material) (depth) 4" (size) if telescope see back.			
(5) screen 0 (length) 0 (depth to top) 0 (size) 0 (material)			
(6) pump 1 1/2 (HP) 7 (yield gpm) Elev (type power)			
(7) electric log No (yes or no) 0 (organization running log)			
(8) how well bottom plugged 0			


CODED

DRILLERS REMARKS:

JUN 7 1973

If well telescopes please sketch and show depths.

GROUND LEVEL

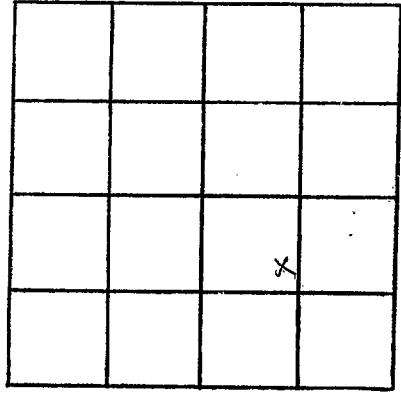

SECTION 23

Please indicate well location X.

ADDITIONAL INFORMATION

A series of horizontal lines for recording additional information, starting below the 'ADDITIONAL INFORMATION' header and extending to the bottom of the page.

If more than one screen, show locations of each on sketch.