

TIPPAH
C 22
3-29-73

MISSISSIPPI
BOARD OF WATER COMMISSIONERS
416 North State Street
Jackson, Mississippi 39201

LODEP

WATER WELL DRILLERS LOG

3-29-73 date well completed
Lumper Well Drilling firm name
Tippah county well located

LANDOWNER:	description of formations encountered	from	to
Newton M. Steward Rt # 2 Walnut, Miss- (mailing address)	mixed CLAY	0	130
WELL LOCATION: sec. 11 T. 2 N. R. 3 E 4 miles W of WALNUT (distance) (direction) (nearest town)	Rock + SAND	130	180
WELL PURPOSE: Home (home, irrigation, municipal, industrial)	<div style="border: 1px solid black; padding: 5px; display: inline-block;">LODEP</div>		
WELL COMPLETION DATA:			
(1) diameter (inches) 4"			
(2) total depth (feet) 180			
(3) static water level (feet) 100 below top of ground.			
(4) casing PVC 140 (material) (depth)			
4" if telescope see back. (size)			
(5) screen 40 140 (length) (depth to top)			
4" PVC (size) (material)			
(6) pump 1 1/2 8 (HP) (yield gpm)			
Elex (type power)			
(7) electric log No (yes or no)			
(organization running log)			
(8) how well bottom plugged PVC CAP			
DRILLERS REMARKS:	JUN 7 1973 MISS. Bd. OF WATER COMM.		


If well telescopes please sketch and show depths.

GROUND LEVEL

Casing 140 ft

Screen 40 ft.

Pelli 180 ft.

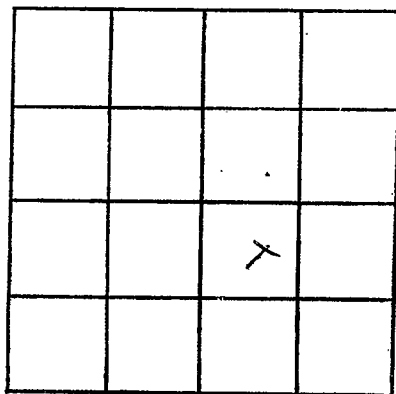

SECTION 11

Please indicate well location X.

ADDITIONAL INFORMATION

Lined area for additional information.

If more than one screen, show locations of each on sketch.