

TIPPAH
C23
5-17-73

MISSISSIPPI
 BOARD OF WATER COMMISSIONERS
 416 North State Street
 Jackson, Mississippi 39201

800.00
 4500
 00

CODED

WATER WELL DRILLERS LOG


5 17 19 23 JT Medler Tippah
 date well completed firm name county well located

LANDOWNER: <u>John Medler</u>	description of formations encountered	from	to
<u>Walnut 7</u> (mailing address)	<u>Clay</u> <u>100' & 100'</u> <u>White Clay</u> <u>Rock & Sand</u>	<u>0</u> <u>15</u> <u>100</u> <u>125</u>	<u>18</u> <u>60</u> <u>175</u> <u>225</u>
WELL LOCATION: sec. <u>11</u> T. <u>2</u> N. R. <u>3</u> E. <u>4</u> miles <u>E</u> of <u>Tippah</u> (distance) (direction) (nearest town)			
WELL PURPOSE: (home, irrigation, municipal, industrial)			
WELL COMPLETION DATA: (1) diameter (inches) <u>4</u> (2) total depth (feet) <u>275</u> (3) static water level (feet) <u>20</u> below above top of ground. (4) casing <u>P</u> <u>120</u> (material) (depth) (size) if telescope see back. (5) screen _____ (length) (depth to top) (size) (material) (6) pump <u>1</u> <u>6</u> (HP) (yield gpm) (type power) (7) electric log _____ (yes or no) (organization running log) (8) how well bottom plugged _____	<p>CODED</p>		
DRILLERS REMARKS:			

MAY 18 1973

If well telescopes please sketch and show depths.

GROUND LEVEL

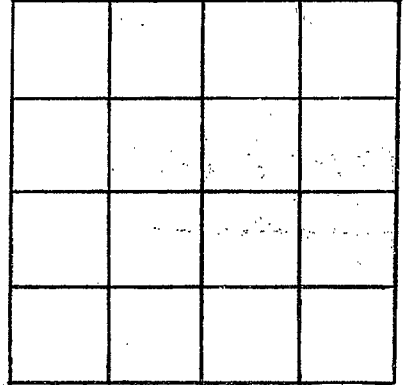

SECTION _____

Please indicate well location X.

ADDITIONAL INFORMATION

If more than one screen, show locations of each on sketch.