

TIPPIAH
 C24
 8-16-74

MISSISSIPPI
 BOARD OF WATER COMMISSIONERS
 416 North State Street
 Jackson, Mississippi 39201

F.H.A. 1,100.00
 TAX 5500
 1,550.00

CODED

WATER WELL DRILLERS LOG

8-16 1974 ~~Sept 6~~ T Madhu Tippah
 date well completed. firm name county well located


LANDOWNER:	description of formations encountered	from	to
Dammie E Thomas	Clay	0	160
Tippahville 38674 (mailing address)	rock & sand	160	370
WELL LOCATION:			
sec. 13 T. 2 N. R. 3 E. S. W.			
4 miles W of Tippahville (distance) (direction) (nearest town)			
WELL PURPOSE: (home, irrigation, municipal, industrial)			
WELL COMPLETION DATA:			
(1) diameter (inches) 30 4			
(2) total depth (feet) 270			
(3) static water level (feet) 108 below top of ground.			
(4) casing (material) (depth) 160			
If telescope see back. (size)			
(5) screen (length) (depth to top)			
(size) (material)			
(6) pump (HP) (yield gpm) 6			
(type power) E			
(7) electric log (yes or no)			
(organization running log)			
(8) how well bottom plugged			
DRILLERS REMARKS:			

DISCONTINUED
 SEP - 5 1974

MISS. BD. OF WATER COMMISSIONERS

If well telescopes please sketch and show depths.

GROUND LEVEL

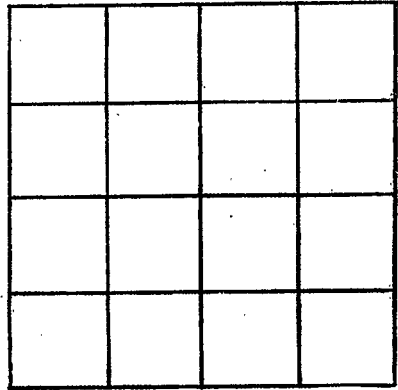

SECTION _____

Please indicate well location X.

ADDITIONAL INFORMATION

If more than one screen, show locations of each on sketch.