

TIPPAH
C 75
2-26-75

MISSISSIPPI
BOARD OF WATER COMMISSIONERS
416 North State Street
Jackson, Mississippi 39201

1500 00
75 00

WATER WELL DRILLERS LOG

226 19 25 J T Medlin Tippah
date well completed firm name county well located

LANDOWNER Ernie Huggins
Sabe Angela
Falhin Miss
(mailing address)

description of formations encountered	from to	
	feet	feet
sand	0	10
clay	10	105
rock & clay	125	305
blue clay	308	325
rock & sand	375	460

WELL LOCATION:
sec 16 T 2 N R 3 E
4 miles S of 72 MI
(distance) (direction) (nearest town)

WELL PURPOSE:
(home, irrigation, municipal, industrial)


- WELL COMPLETION DATA:
- (1) diameter (inches) 4
 - (2) total depth (feet) 460
 - (3) static water level (feet) 160 below top of ground.
 - (4) casing P 360
(material) (depth)
(size) if telescope see back
 - (5) screen _____
(length) (depth to top)
(size) (material)
 - (6) pump 3/4 _____
(HP) (yield gpm)
(type power)
 - (7) electric log C
(yes or no)
(organization running log)
 - (8) how well bottom plugged O

DRILLERS REMARKS:

RECEIVED
MAR 20 1975

If well telescopes please sketch and show depths.

GROUND LEVEL

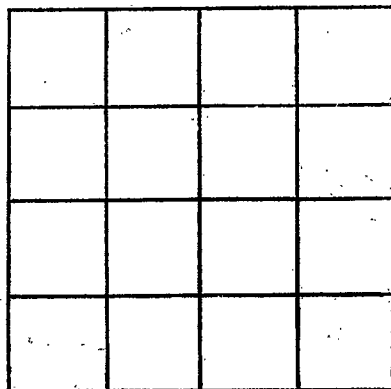

SECTION _____

Please indicate well location X.

ADDITIONAL INFORMATION

If more than one screen, show locations of each on sketch.