

TIPPAN  
 C26  
 2-27-75

MISSISSIPPI  
 BOARD OF WATER COMMISSIONERS  
 416 North State Street  
 Jackson, Mississippi 39201

WATER WELL DRILLERS LOG

CODED

FEB 27  
 date well completed

1975 Billy R. Simpson  
 firm name

TIPPAN  
 county well located

LANDOWNER:	description of formations encountered	from	to
EDGAR L. BRADDOCK	SURFACE CLAY	0	20
FALICKER, MISS (mailing address)	SHALLOVE CLAY	20	46
	BLUE CLAY	46	61
	POUC	61	63
	BLUE CLAY	63	162
	GRAVEL	162	164
	BLUE CLAY	164	210
	LIME STONE + SAND	210	234
	BLUE CLAY	234	260
	LIME STONE + SAND	260	310

WELL LOCATION:  
 sec. 23 T 2 N R 3 E  
 S W  
 3 miles NW of FALICKER  
 (distance) (direction) (nearest town)

WELL PURPOSE: WORLD  
 (home, irrigation, municipal, industrial)

- WELL COMPLETION DATA:
- (1) diameter (inches) 4
  - (2) total depth (feet) 310
  - (3) static water level (feet) 124 below top of ground.
  - (4) casing POC, 175' (material), (depth)
  - \_\_\_\_\_ if telescope see back. (size)
  - (5) screen None (length), (depth to top)
  - \_\_\_\_\_ (size) (material)
  - (6) pump 3/4 (HP), 10 (yield gpm)
  - Elec (type power)
  - (7) electric log No (yes or no)
  - \_\_\_\_\_ (organization running log)
  - (8) how well bottom plugged \_\_\_\_\_

CODED


REGISTERED  
 APR - 7 1975

MISS. BD. OF WATER COMM

DRILLERS REMARKS: CASING COLLAPSED AT 95' - 115'. COULD HAVE BEEN BAD CASING OR SIMPSONS (20-40) CASE IN. BACK FILLED - OK.

If well telescopes please sketch and show depths.

GROUND LEVEL

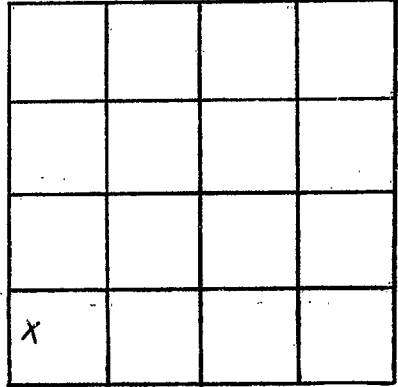

SECTION 23

Please indicate well location X.

ADDITIONAL INFORMATION

If more than one screen,  
show locations of each on sketch.