

Tipsoh
C 28
6-30-74

MISSISSIPPI
BOARD OF WATER COMMISSIONERS
416 North State Street
Jackson, Mississippi 39201

800.00
TAX 40.00

WATER WELL DRILLERS LOG

CODED

630 1924 J.T. Medlin Tipsoh
date well completed firm name county well located

LANDOWNER: Joe Crawford
Wardwell H.W.
72 W
(mailing address)

description of formations encountered	from	to
Clay	0	26
SCUMM ROCK	26	90

WELL LOCATION:
sec 2 T 2 N R 3 E 16L
6 miles SW of Leake
(distance) (direction) (nearest town)

WELL PURPOSE:
(home, irrigation, municipal, industrial)

CODED


- WELL COMPLETION DATA:
- (1) diameter (inches) 4
 - (2) total depth (feet) 90
 - (3) static water level (feet) 60 below top of ground.
 - (4) casing P 90 (material) (depth)
 - (size) If telescope see back.
 - (5) screen 10 80 (length) (depth to top)
 - (size) P (material)
 - (6) pump 1/2 6 (HP) (yield gpm)
 - (type power)
 - (7) electric log (yes or no)
 - (organization running log)
 - (8) how well bottom plugged Clay

INTEGRITY
KIS
DATE - 9 1975

DRILLERS REMARKS:

If well telescopes please sketch and show depths.

GROUND LEVEL

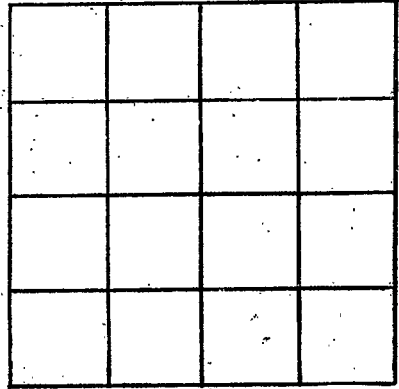

SECTION _____

Please indicate well location X.

ADDITIONAL INFORMATION

If more than one screen,
show locations of each on sketch.