

Tippah
 C 29
 7-19-75

MISSISSIPPI
 BOARD OF WATER COMMISSIONERS
 416 North State Street
 Jackson, Mississippi 39201 **CODED**

WATER WELL DRILLERS LOG

7 79 19 25 J.T. Maddox Tippah
 date well completed firm name county well located

LANDOWNER: J. Maddox
 description of formations encountered
 Walnut
 H.W. 72 West
 (mailing address)
 from 0 to 18
 clay
 rock + sand 18 100

WELL LOCATION:
 sec 3 T 2 N R 3 E 16 L
 6 miles SW of Walnut
 (distance) (direction) (nearest town)

WELL PURPOSE:
 (home, irrigation, municipal, industrial)

- WELL COMPLETION DATA:
- (1) diameter (inches) 4
 - (2) total depth (feet) 110
 - (3) static water level (feet) 20 below top of ground.
 - (4) casing P 110 (material) (depth)
 - (size) If telescope see back.
 - (5) screen 10 100 (length) (depth to top)
 - 4 P (size) (material)
 - (6) pump 1/2 6 (HP) (yield gpm)
 - E (type power)
 - (7) electric log (yes or no)
 - (organization running log)
 - (8) how well bottom plugged Cafe


DRILLERS REMARKS:

RECEIVED
 MISSISSIPPI
 AUG 11 1975

MISS. BU. OF WATER COMMISSIONERS

If well telescopes please sketch and show depths.

GROUND LEVEL

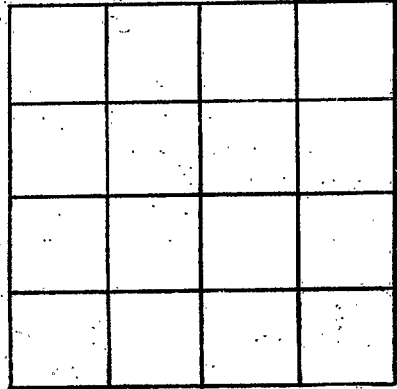

SECTION _____

Please indicate well location X.

ADDITIONAL INFORMATION

If more than one screen, show locations of each on sketch.