

TIPPAA
 C30
 9-9-75

MISSISSIPPI
 BOARD OF WATER COMMISSIONERS
 416 North State Street
 Jackson, Mississippi 39201

16L

WATER WELL DRILLERS LOG

CODED

SEPT. 9 1975
 date well completed

~~W.C.~~
 J.T. Modlin

Tippah
 county well located

LANDOWNER:

LEE BROWN

description of formations encountered

from to

WALNUT

~~250~~

(mailing address)

~~220~~

WELL LOCATION:

sec 7 1/2 N 03 E
 7 miles W of WALNUT
 (distance) (direction) (nearest town)

CLAY

0-350

WELL-PURPOSE:

(home, irrigation, municipal, industrial)

SAND + GRAVEL

30-120

WELL COMPLETION DATA:

- (1) diameter (inches) 4
- (2) total depth (feet) 420
- (3) static water level (feet) 130 below above top of ground.
- (4) casing P 250
 (material) (depth)
 _____ if telescope see back.
 (size)
- (5) screen _____
 (length) (depth to top)
 (size) _____ (material) _____
- (6) pump 1/2 8
 (HP) (yield gpm)
E
 (type power)
- (7) electric log _____
 (yes or no)

 (organization running log)
- (8) how well bottom plugged _____


TURN WEST on
 72 at WALNUT
 go 3 miles to
 MARTINDALES store
 TAKE left.

DRILLERS REMARKS:

MISSISSIPPI BOARD OF WATER COMMISSIONERS
 OCT 16 1975

If well telescopes please sketch and show depths.

GROUND LEVEL

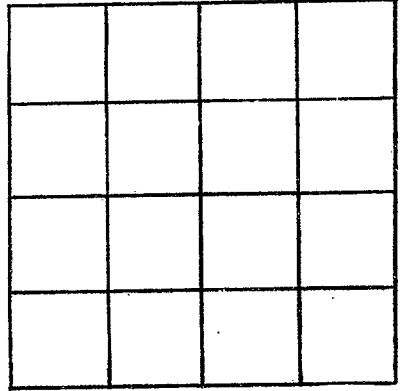

SECTION _____

Please indicate well location X.

ADDITIONAL INFORMATION

If more than one screen, show locations of each on sketch.