

need measured ton

Tippah
C 2000
10-31-75

MISSISSIPPI
BOARD OF WATER COMMISSIONERS
416 North State Street
Jackson, Mississippi 39201

WATER WELL DRILLERS LOG

Robert W. Wilson

10-31
date well completed

19 25
firm name

Tippah
county well located

LANDOWNER:

Victor Walker

Dupplumville, Miss.
(mailing address)

WELL LOCATION:

sec. 15 T. 2 N. R. 3 E. S. W.
(distance) miles (direction) of (nearest town)

WELL PURPOSE:

(home, irrigation, municipal, industrial)

WELL COMPLETION DATA:

- (1) diameter (inches) 4
- (2) total depth (feet) 135
- (3) static water level (feet) 120 below above top of ground.
- (4) casing (material) (depth) 125
- 4 (size) If telescope see back.
- (5) screen (length) (depth to top) 10 125
- 4 (size) gravel packed (material)
- (6) pump (HP) (yield gpm) 3/4 10
- electric (type power)
- (7) electric log (yes or no)

(organization running log)

(8) how well bottom plugged 4" plastic cap

description of formations encountered	from	to
Brown clay	0	12
Gray clay	12	15
Black clay	15	110
Rock	110	114
Clay	114	120
Black clay	120	125
Gray sand	125	132
Black clay	132	135


DRILLERS REMARKS:

DISCOVERED WATER
MAY 13 1976

MISS. BD. OF WATER COMMISSIONERS

If well telescopes please sketch and show depths.

GROUND LEVEL

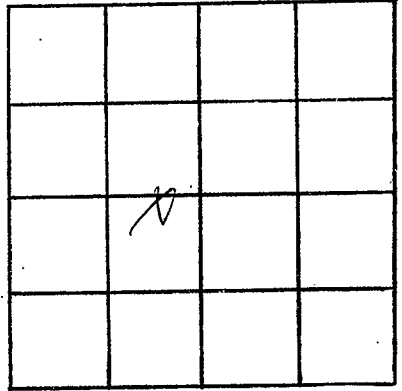

SECTION RS

Please indicate well location X.

ADDITIONAL INFORMATION

If more than one screen,
show locations of each on sketch.