

TIPPAH
 C 2001
 6-12-78

MISSISSIPPI
 BOARD OF WATER COMMISSIONERS
 416 North State Street
 Jackson, Mississippi 39201

WATER WELL DRILLERS LOG

Tippek
~~Beaton~~

6-12 19 78 Wilson Well Co. Inc. date well completed firm name county well located

LANDOWNER: Kenneth Porter
2027 Hallwood Dr.
Memphis, TN
 (mailing address)

description of formations encountered	from	to
Blue clay	0	5
Brown sand	5	30
white sand, white clay	30	43
white sand	45	75
white clay	75	99

WELL LOCATION:
 sect 1 T 2 N R 3 E
? miles ? of ?
 (distance) (direction) (nearest town)

WELL PURPOSE:
 (home, irrigation, municipal, industrial)

WELL COMPLETION DATA:
 (1) diameter (inches) 4
 (2) total depth (feet) 99
 (3) static water level (feet) 70 below top of ground.
 (4) casing plastic, 89 (material) (depth)
 (size) if telescope see back.
 (5) screen 10, 89 (length) (depth to top)
 (size) gran. packed (material)
 (6) pump 3/4, 10 (HP) (yield gpm)
electric (type power)
 (7) electric log (yes or no)
 (organization running log)


(8) how well bottom plugged 4"
plastic cap

DRILLERS REMARKS:

RECEIVED
 OCT 23 1978
 MISS. BD. OF WATER COMMISSIONERS

If well telescopes please sketch and show depths.

GROUND LEVEL

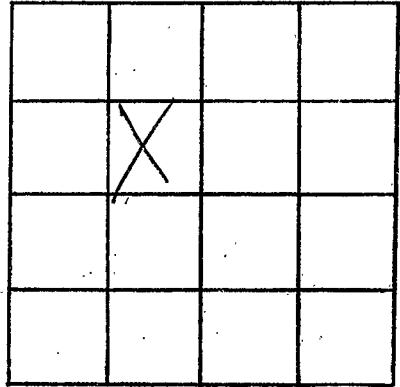

SECTION 15

Please indicate well location X.

ADDITIONAL INFORMATION

If more than one screen, show locations of each on sketch.