

Tippah
 C 2002
 7-17-79

MISSISSIPPI
 BOARD OF WATER COMMISSIONERS
 416 North State Street
 Jackson, Mississippi 39201

WATER WELL DRILLERS LOG

7-17-1979 date well completed Robert W. Wilson firm name Tippah county well located

LANDOWNER:
 Russell Harwood
 1004 East Elmwood Crawfordsville
 (mailing address)

description of formations encountered	from	to
Red clay + Red Sand	0	30
white to blue white Sand	30	60
white Sand	60	80

WELL LOCATION:
 sec 21 T 2 N R 3 E
 (distance) miles of (direction) (nearest town)

WELL PURPOSE:
 (home, irrigation, municipal, industrial)

- WELL COMPLETION DATA:
- (1) diameter (inches) 4
 - (2) total depth (feet) 20
 - (3) static water level (feet) 30 below top of ground.
 - (4) casing 40 (material) (depth)
4 If telescope see back. (size)
 - (5) screen 10 (length) (depth to top)
gravel packs (size) (material)
 - (6) pump 3/4 (HP) 10 (yield gpm)
electric (type power)
 - (7) electric log (yes or no)

(organization running log)

(8) how well bottom plugged 4"
plastic cap

DRILLERS REMARKS:


Miss. Board of Water Comm.

JUL 30 1979

RECEIVED

If well telescopes please sketch and show depths.

GROUND LEVEL

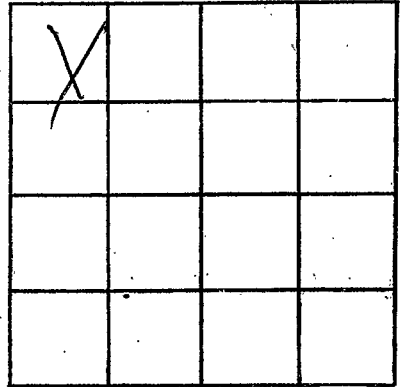

SECTION 21

Please indicate well location X.

ADDITIONAL INFORMATION

If more than one screen, show locations of each on sketch.