

Tippah  
 C 2003  
 6-22-79

MISSISSIPPI  
 BOARD OF WATER COMMISSIONERS  
 416 North State Street  
 Jackson, Mississippi 39201

WATER WELL DRILLERS LOG

Tippah

6-22 19 79 Robert Williams Tippah  
 date well completed firm name county well located

LANDOWNER:  
 Frances Callahan  
 Rt 1 Box 125 Inverness, Ms.  
 (mailing address)

description of formations encountered	from	to
Red clay Blue clay	0	30
Blue clay	30	300
Blue clay rocks	300	400
Blue clay, green sand	400	410
Green Saturated Rocks	410	515

WELL LOCATION:  
 sec. 23 T-2 N R-3 E  
 (distance) miles (direction) of (nearest town)

WELL PURPOSE:  
 (home, irrigation, municipal, industrial)

- WELL COMPLETION DATA:
- (1) diameter (inches) 4
  - (2) total depth (feet) 515
  - (3) static water level (feet) 195 below above top of ground.
  - (4) casing (material) (depth) (size) If telescope see back.
  - (5) screen 1 (length) (depth to top) (size) gravel packed (material)
  - (6) pump 3/4 (HP) 10 (yield gpm) electric (type power)
  - (7) electric log (yes or no) (organization running log)
  - (8) how well bottom plugged 4" plaster cap

DRILLERS REMARKS:


Miss. Board of Water Comm.

JUL 30 1979

RECEIVED

If well telescopes please sketch and show depths.

GROUND LEVEL

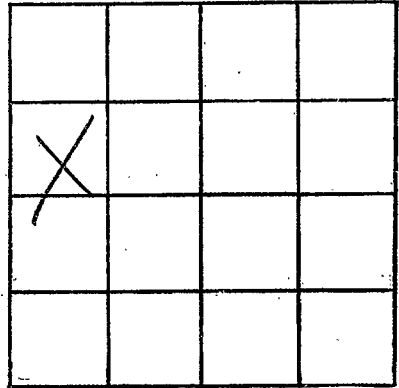

SECTION 23

Please indicate well location X.

ADDITIONAL INFORMATION

If more than one screen, show locations of each on sketch.