

MISSISSIPPI
BOARD OF WATER COMMISSIONERS
416 North State Street
Jackson, Mississippi 39201

WATER WELL DRILLERS LOG

TEPPAH
C 2004
11/3/80
11-3

date well completed

1980 Front Well Supply

firm name

Teppah

county well located

LANDOWNER:

Jim Jagger
Walnut, Miss.
(mailing address)

description of formations encountered

from

to

<u>Clay</u>	<u>0</u>	<u>40</u>
<u>Sand</u>	<u>40</u>	<u>50</u>
<u>Clay</u>	<u>50</u>	<u>300</u>
<u>Sand</u>	<u>300</u>	<u>310</u>
<u>Clay & Rocks</u>	<u>310</u>	<u>380</u>
<u>Sand</u>	<u>380</u>	<u>440</u>

WELL LOCATION:

sec. 1 T. 2 N. R. 3 E
10 miles SE of Walnut
(distance) (direction) (nearest town)

WELL PURPOSE:

(home, irrigation, municipal, industrial)

WELL COMPLETION DATA:

- (1) diameter (inches) 4
- (2) total depth (feet) 440
- (3) static water level (feet) 160 below top of ground
- (4) casing PVC 420
(material) (depth)

_____ if telescope see back.
(size)

- (5) screen 10' 430
(length) (depth to top)
1/2" PVC
(size) (material)

- (6) pump 3/4 10
(HP) (yield gpm)

els
(type power)

- (7) electric log no
(yes or no)

_____ (organization running log)

- (8) how well bottom plugged Cap

DEPT. OF NATURAL RESOURCES
BUREAU OF LAND & WATER RESOURCES


MAR 6 1981

RECEIVED

DRILLERS REMARKS:

If well telescopes please sketch and show depths.

GROUND LEVEL

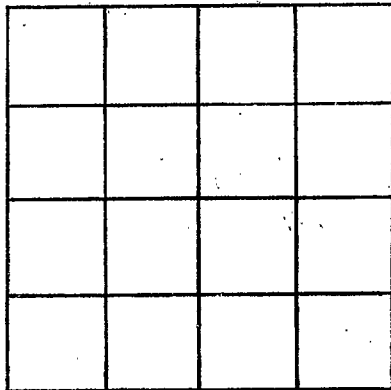

SECTION _____

Please indicate well location X.

ADDITIONAL INFORMATION

If more than one screen, show locations of each on sketch.