

**MISSISSIPPI DEPARTMENT OF NATURAL RESOURCES**  
**Bureau of Land and Water Resources**  
 Southport Mall  
 P.O. Box 10631  
 Jackson, Mississippi 39209  
**WATER WELL DRILLERS LOG**

Tippah  
C  
2000

March 31 19 83 ~~Wilson Well Co. Inc~~ Wilson Well Co. Inc Tippah  
 date well completed firm name county well located

LANDOWNER: Annie Hopkins  
Route 1 Box 220  
Faulkner, MS  
 (mailing address)

WELL LOCATION:  
 sec. 20 T. 2 N. R. 3 E  
12 miles SW of Walnut  
 (distance) (direction) (nearest town)

description of formations encountered	from	to
Red Clay - White Clay	0	30
White Clay	30	41
White Sand	41	45
Blue Clay	45	207
Rock	207	209
Blue Clay	209	225
Blue Clay	225	325
Rock	325	337
Blue Clay	337	380
Blue Clay - Rock	380	385
Green Sand - Rock	385	400
Rock - Green Sand	400	425

WELL PURPOSE: Home  
 (home, irrigation, municipal, industrial)

- WELL COMPLETION DATA:
- diameter (inches) 4
  - total depth (feet) 425
  - static water level (feet) 185 below top of ground
  - casing (material) Plastic, (depth) 425
  - screen (length) 4, (depth to top) Plastic
  - pump (HP) 3/4, (yield gpm) 8
  - electric log (type power) Electric
  - electric log (yes or no) No
- (organization running log)
- (8) how well bottom plugged 4-Plastic Cap

DRILLERS REMARKS:


DEPT. OF NATURAL RESOURCES  
 BUREAU OF LAND & WATER RESOURCES

JUN 20 1983

**RECEIVED**

If well telescopes please sketch and show depths.

GROUND LEVEL

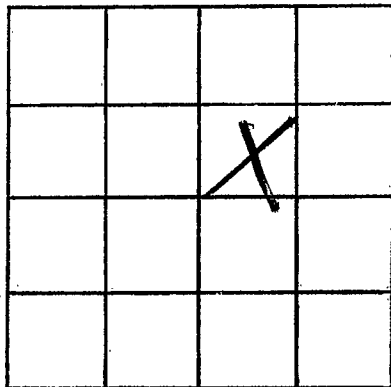

SECTION 20

Please indicate well location X.

ADDITIONAL INFORMATION

If more than one screen,  
show locations of each on sketch.