

MISSISSIPPI DEPARTMENT OF NATURAL RESOURCES

Bureau of Land and Water Resources

Southport Mall

P.O. Box 10631

Jackson, Mississippi 39209

WATER WELL DRILLERS LOG

LIPPART  
C  
2007

5-3-86 19 Wilson Well Co. Inc. Lippart  
date well completed firm name county well located

LANDOWNER: Frank For  
3687 Autom  
Memphis, In.  
(mailing address)

WELL LOCATION:  
sec. 20 T. 2 N R. 3 E  
4 miles NW of Frankfort  
(distance) (direction) (nearest town)

WELL PURPOSE: none  
(home, irrigation, municipal, industrial)

WELL COMPLETION DATA:  
(1) diameter (inches) 4  
(2) total depth (feet) 400  
(3) static water level (feet) 10 below above top of ground.  
(4) casing PVC, 390, (material) (depth) 4" (size) if telescope see back.  
(5) screen 10, 390 (length) (depth to top) 4" (size) PVC (material)  
(6) pump 1, 18 (HP) (yield gpm) elect. (type power)  
(7) electric log (yes or no)  
(organization running log)  
(8) how well bottom plugged 4" PVC Cap

description of formations encountered	from	to
Red Clay + Red Sand	0	15
W. Sand W. Clay B. Sand	15	30
Blue clay	30	290
Blue clay + sand	290	310
Blue Clay	310	323
Rock	323	324
sand	324	325
Blue clay	325	328
Rock	328	329
Rock + Sand	329	334
Rock	334	335
Rock + clay	335	340
Rock Blue Clay + Sand	340	350
Blue clay + Sand	350	355
Rock	355	356
Sand + Rock	356	365
Green sand + Rock	365	380
" " "	380	410


RECEIVED  
SEP 08 1986

Department of Natural Resources  
Bureau of Land & Water Resources

DRILLERS REMARKS:

If well telescopes please sketch and show depths.

GROUND LEVEL

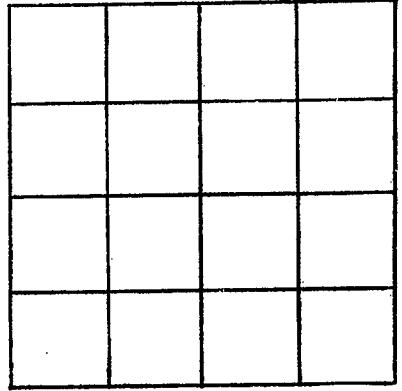

SECTION \_\_\_\_\_

Please indicate well location X.

ADDITIONAL INFORMATION

If more than one screen,  
show locations of each on sketch.