

Tippah  
29  
10-66

MISSISSIPPI BOARD OF WATER COMMISSIONERS

**CODED**

**WATER WELL DRILLERS LOG**

Date: 10-30-1966, Driller: Layne-Central Co. County: Tippah

(Name)

(1) Owner of Land: Chalybeate Water Assn.  
(Name)

Chalybeate, Mississippi

(Address)

(2) Location: 1/4, 1/4, Sec. 3 24 10 T3 R5 E

\_\_\_\_\_ miles \_\_\_\_\_ of \_\_\_\_\_  
(distance) (direction) (Nearest Town)

(3) Topography: \_\_\_\_\_  
(Hilly) (Flat) (Level)

(4) Purpose of Well: Municipal  
(Domestic Irrigation, Municipal, Industrial, Other)

Information upon completion of well:

(1) Diameter 8 inches.

(2) Total Depth 861 feet.

(3) Water Level 180 feet below top of ground.

(4) Cased to 808', Size 8"

(5) Screen: Size 4", Length 30'

(6) Were any formations sealed against pollution?


yes, \_\_\_\_\_ no.

If YES depth of formation 808'

Why \_\_\_\_\_ required

Drillers Remarks:

Description & Color of Materials Sand, Clay, Red Clay, Shell, etc.	Thick- ness Feet	Depth Feet
Red sand	0-25	
clay	25-52	
rock	52-55	
clay	55-61	
rock	61-63	
clay	63-95	
rock	95-96	
sandy shale-sand	96-176	
rock	176-177	
hard sandy shale	177-184	
rock	184-185	
shale	185-220	
shale & boulders	220-250	
sandy shale	250-342	
tough shale-boulders	342-417	
shale	417-461	
rock	461-463	
shale-boulders	463-690	
rock	690-691	
shale	691-750	
rock	750-752	
shale	752-760	
sandy shale	760-764	
sand-shale	764-800	
hard clay	800-805	
sand-shale st.	805-856	
shale-sand st.	856-861	

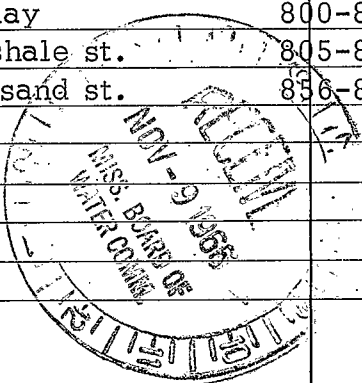

(Use Back Side)

Well No.

