

MISSISSIPPI
BOARD OF WATER COMMISSIONERS
416 North State Street
Jackson, Mississippi 39201

CODED

WATER WELL DRILLERS LOG

TIPPAH
D 11
8-11-70

Aug 11 1970 date well completed
J. W. Webb & Sons firm name
Tipphah county well located

LANDOWNER: Mrs. R. O. Brunckly	description of formations encountered	from	to
Tipphahville, Miss (mailing address)	Soil	0	4
	Sand	4	16
	Sand Rock	16	19
	Sand & Rock	19	80
	Blue Clay & Sand	80	114
	Water Sand	114	139
WELL LOCATION: sec. 20 T 25 N R 4 E 0 miles East of Tipphahville (distance) (direction) (nearest town)			
WELL PURPOSE: (home, irrigation, municipal, industrial)			
WELL COMPLETION DATA:			
(1) diameter (inches) 4			
(2) total depth (feet) 135			
(3) static water level (feet) 101 below top of ground.			
(4) casing Plastic, 127 (material) (depth)			
(size) if telescope see back.			
(5) screen 8 127 (length) (depth to top)			
4 Plastic (size) (material)			
(6) pump 1/2 HP sub 8 (HP) (yield gpm)			
Ebe (type power)			
(7) electric log 10 (yes or no)			
(organization running log)			
(8) how well bottom plugged cap			
DRILLERS REMARKS:			


CODED

SEP 8 1970

MISS. BD. OF WATER COMM

If well telescopes please sketch and show depths.

GROUND LEVEL

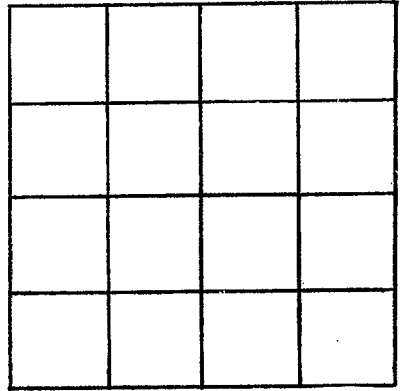

SECTION _____

Please indicate well location X.

ADDITIONAL INFORMATION

If more than one screen, show locations of each on sketch.