

TIPPAH

OD12

12-22-70

MISSISSIPPI BOARD OF WATER COMMISSIONERS
416 North State Street
Jackson, Mississippi 39201

CODED

WATER WELL DRILLERS LOG

12 22 1970
date well completed

J T Medlin
firm name

Tippah
county well located

LANDOWNER: K. V. Haddix

description of formations encountered

from to

Walnut R# 2.
(mailing address)

| | | |
|-----------|-----|-----|
| Clay | 0 | 16 |
| Sand | 16 | 28 |
| Blue clay | 28 | 82 |
| Sand | 82 | 116 |
| Blue " | 116 | 126 |
| Rock | 126 | 198 |
| Sand | 198 | 230 |

WELL LOCATION:

sec. 6 T. 2 N. R. 4 E.
3 miles S.W. of Walnut
(distance) (direction) (nearest town)

WELL PURPOSE:

(home, irrigation, municipal, industrial)

WELL COMPLETION DATA:

- (1) diameter (inches) 4
- (2) total depth (feet) 230
- (3) static water level (feet) 100 below top of ground.
- (4) casing P 132
(material) (depth)
(size) if telescope see back.
- (5) screen _____
(length) (depth to top)
(size) (material)
- (6) pump 1 HP 4
(HP) (yield gpm)
E
(type power)
- (7) electric log _____
(yes or no)
(organization running log)
- (8) how well bottom plugged bn

CODED


JAN 4 1971

DRILLERS REMARKS:

MISS. BD. OF
WATER COMMISSIONERS

If well telescopes please
sketch and show depths.

GROUND LEVEL

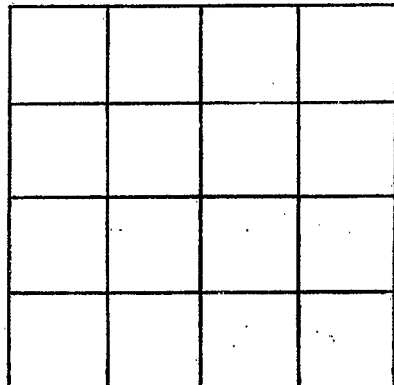

SECTION _____

Please indicate well location X.

ADDITIONAL INFORMATION

If more than one screen,
show locations of each on sketch.