

TIPPAH
 D 13
 3-16-71

MISSISSIPPI
 BOARD OF WATER COMMISSIONERS
 416 North State Street
 Jackson, Mississippi 39201

CODED

WATER WELL DRILLERS LOG

3-16 1971 J & T Madlin Tippah
 date well completed firm name county well located

LANDOWNER: See Motherford
Falkner
 (mailing address)

description of formations encountered	from	to
Clay	0	13
Rock & clay	13	65
Blue	65	108
Sand	108	170

WELL LOCATION:
 sec. 31 T. 2 N. R. 4E
2 miles S of Tiptonville
 (distance) (direction) (nearest town)

WELL PURPOSE:
 (home, irrigation, municipal, industrial)

- WELL COMPLETION DATA:
- (1) diameter (inches) 4
 - (2) total depth (feet) 170
 - (3) static water level (feet) 30 below above top of ground.
 - (4) casing P 80
 (material) (depth)
 (size) if telescope see back.
 - (5) screen _____
 (length) (depth to top)
 (size) (material)
 - (6) pump 3/4 6
 (HP) (yield gpm)
6
 (type power)
 - (7) electric log _____
 (yes or no)
 (organization running log)
 - (8) how well bottom plugged _____

CODED


APR - 6 1971

MISS. DE. OF
 WATER COMM.

DRILLERS REMARKS:

If well telescopes please
sketch and show depths.

GROUND LEVEL

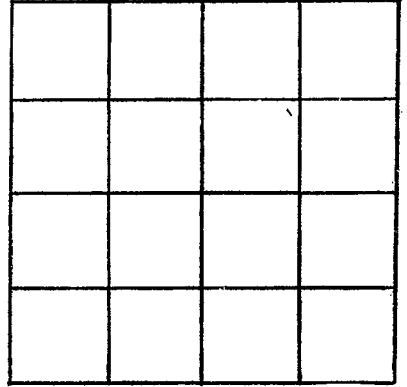

SECTION _____

Please indicate well location X.

ADDITIONAL INFORMATION

If more than one screen,
show locations of each on sketch.