

Tippah  
DIA  
9-65

MISSISSIPPI BOARD OF WATER COMMISSIONERS

WATER WELL DRILLERS LOG **CODED**

Date: 9-1-1965, Driller: Layne-Central Co., County: Tippah

(Name)

(1) Owner of Land: Tiplersville Water Assn.  
(Name)  
Tiplersville, Mississippi  
(Address)

(2) Location: 1/4, 1/4, Sec. T R R  
\_\_\_\_\_ miles \_\_\_\_\_ of \_\_\_\_\_  
(distance) (direction) (Nearest Town)

(3) Topography: \_\_\_\_\_  
(Hilly) (Flat) (Level)

(4) Purpose of Well: Municipal  
(Domestic Irrigation  
Municipal, Industrial, Other)

Description & Color of Materials Sand, Clay, Red Clay, Shell, etc.	Thick- ness Feet	Depth Feet
		0
sandy clay	5	5
clay	29	34
blue marl	35	69
rock	1	70
blue marl	6	76
rock	4	80
clay	4	84
rock	8	92
clay	4	96
rock	3	99
clay	18	117
rock	5	122
sand	3	125
rock	1	126
sand	3	129
rock	1	130
sand	5	135
rock	1	136
sand	3	139
rock	2	141
sand	2	143
rock	1	144
sand	18	162
rock	1	163
sand	5	168
rock	1	169
sand	7	176
rock	1	177
sand	13	190
rock	3	193
shale	10	213

**CODED**

Information upon completion of well:

(1) Diameter 10 inches.

(2) Total Depth 194 feet.

(3) Water Level 63 feet below top of ground.

(4) Cased to 123', Size 10"


(5) Screen: Size 6", Length 60'

(6) Were any formations sealed against pollution?  
X yes, \_\_\_\_\_ no.

If YES depth of formation 123'

Why \_\_\_\_\_ required

Drillers Remarks: \_\_\_\_\_

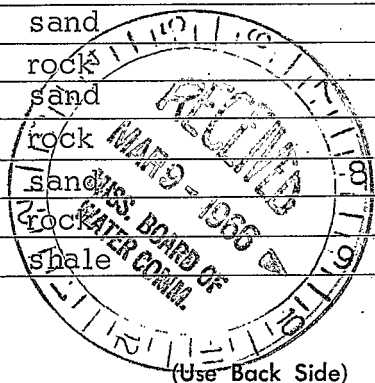

(Use Back Side)

Well No.

100

100