

TIPPAH
D16
7-31-72

MISSISSIPPI
BOARD OF WATER COMMISSIONERS
416 North State Street
Jackson, Mississippi 39201

CODED

WATER WELL DRILLERS LOG

7-31-72 19 R.W. Wilson Tippah
date well completed firm name county well located

LANDOWNER: James W. Grant

description of formations encountered from to

Rt. 3
Walnut, Miss.
(mailing address)

red clay and sand	0	30
red sand, blue clay	30	60
blue clay, white clay		
white sand	60	90
white sand	90	105
white clay, white sand	105	120
white sand	120	130

WELL LOCATION:
sec. 2 T 2 N R 4 E
S W
miles (distance) of (direction) of (nearest town)

WELL PURPOSE:
(home, irrigation, municipal, industrial)

WELL COMPLETION DATA:


- (1) diameter (inches) 4
- (2) total depth (feet) 122
- (3) static water level (feet) 95 below top of ground.
- (4) casing (material) 1 1/4 (depth)
- (size) if telescope see back.
- (5) screen 8 (length) 114 (depth to top)
- (size) 4 (material) gravel pack
- (6) pump 3/4 (HP) 10 (yield gpm)
- electric (type power)
- (7) electric log (yes or no)
- (organization running log)
- (8) how well bottom plugged 4 inch plastic cap

DRILLERS REMARKS:

NOV 27 1972

If well telescopes please sketch and show depths.

GROUND LEVEL

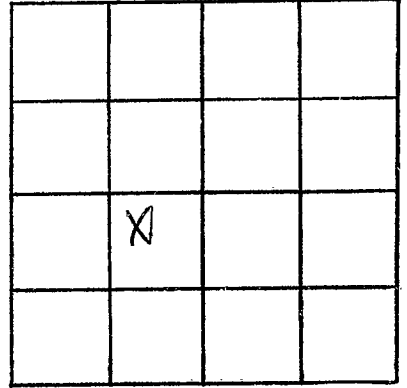

SECTION 2

Please indicate well location X.

ADDITIONAL INFORMATION

If more than one screen,
show locations of each on sketch.