

MISSISSIPPI
BOARD OF WATER COMMISSIONERS
416 North State Street
Jackson, Mississippi 39201

CODED

WATER WELL DRILLERS LOG

TIPPAH
D 17
8-31-72

8-31-72 19 R. W. Wilson Tippah
date well completed firm name county well located

LANDOWNER: Bill Calvey

description of formations encountered from to

Walnut, Miss.
(mailing address)

<u>Red Clay + Red sand</u>	<u>0</u>	<u>15</u>
<u>yellow sand + white clay</u>	<u>15</u>	<u>33</u>
<u>Blue clay + sand rocks</u>	<u>33</u>	<u>45</u>
<u>Blue clay</u>	<u>45</u>	<u>61</u>
<u>rock</u>	<u>61</u>	<u>67</u>
<u>Blue clay</u>	<u>67</u>	<u>75</u>
<u>Blue clay + sand rocks</u>	<u>75</u>	<u>90</u>
<u>Blue clay + sand</u>	<u>90</u>	<u>105</u>
<u>Blue clay + sand + sand rocks</u>	<u>105</u>	<u>112</u>
<u>Blue clay + sand rocks</u>	<u>112</u>	<u>120</u>
<u>Blue clay + sand + sand rocks</u>	<u>120</u>	<u>135</u>
<u>yellow sand</u>	<u>135</u>	<u>165</u>

WELL LOCATION:

sec. 4 T. 2 N R. 4 E
(distance) (direction) (nearest town)

WELL PURPOSE:
(home, irrigation, municipal, industrial)

WELL COMPLETION DATA:


- (1) diameter (inches) 4
- (2) total depth (feet) 164
- (3) static water level (feet) 135 below above top of ground.
- (4) casing 156 (material) (depth)
if telescope see back.
(size)
- (5) screen 8 156 (length) (depth to top)
4 Drum sand (size) (material)
- (6) pump 3/4 10 (HP) (yield gpm)
electric (type power)
- (7) electric log _____ (yes or no)
(organization running log)
- (8) how well bottom plugged square plastic cap

DRILLERS REMARKS:

NOV 27 1972

If well telescopes please sketch and show depths.

GROUND LEVEL

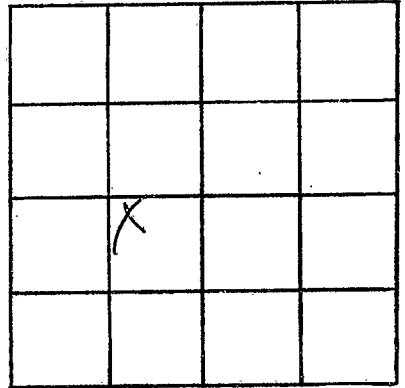

SECTION F

Please indicate well location X.

ADDITIONAL INFORMATION

If more than one screen,
show locations of each on sketch.