

TIPPAH
D 18
12-1-72

MISSISSIPPI
BOARD OF WATER COMMISSIONERS
416 North State Street
Jackson, Mississippi 39201

* 700 00
75 00
3.00

CODED

WATER WELL DRILLERS LOG

12-1-72
date well completed

1972 J T Medina
firm name

Tippah
county/well located

LANDOWNER:

Will Stony

(mailing address)

description of formations encountered

from

to

Clay	0	13
blue	13	31
Rock + Clay	31	127
Rock + Sand	127	150

WELL LOCATION:

sec. 33 T 2 N R 4 E
4 miles E of Falkner
(distance) (direction) (nearest town)

WELL PURPOSE:

(home, irrigation, municipal, industrial)

WELL COMPLETION DATA:

- (1) diameter (inches) 4
- (2) total depth (feet) 150
- (3) static water level (feet) 110 below above top of ground.
- (4) casing P 120
(material) (depth)
(size) if telescope see back.
- (5) screen 0
(length) (depth to top)
(size) (material)
- (6) pump 6 5
(HP) (yield gpm)
(type power)
- (7) electric log
(yes or no)
(organization running log)

CODED

(8) how well bottom plugged Open


FEB 5 1973

DRILLERS REMARKS:

MISC. CH.
WATER CO.

If well telescopes please
sketch and show depths.

GROUND LEVEL

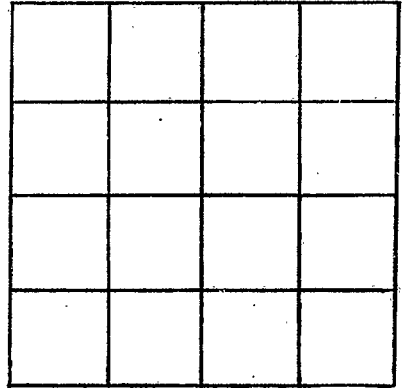

SECTION _____

Please indicate well location X.

ADDITIONAL INFORMATION

If more than one screen,
show locations of each on sketch.