

Ed

D 19
 TIPPAH
 7-5-73

MISSISSIPPI
 BOARD OF WATER COMMISSIONERS

416 North State Street
 Jackson, Mississippi 39201

CODED

dep 42.00
 887.00

WATER WELL DRILLERS LOG

Tippah

7-5 1973
 date well completed

J T Medlin
 firm name

county well located

LANDOWNER:
 Robert Cain
 Walnut
 (mailing address)

description of formations encountered

from to

Clay

0 32

Rock + Clay

32 116

Blue Rock + Sand

116 163
 163 290

WELL LOCATION:

sec 6 T 2 S R 4 E
 3 miles W of Walnut
 (distance) (direction) (nearest town)

WELL PURPOSE:

(home, irrigation, municipal, industrial)

WELL COMPLETION DATA:

- (1) diameter (inches) 4
- (2) total depth (feet) 290
- (3) static water level (feet) 80 below top of ground.
- (4) casing P 130 (material) (depth)
- (size) If telescope see back.
- (5) screen D (length) (depth to top)
- (size) 1/2 (material)
- (6) pump 12 6 (HP) (yield gpm)
- C (type power)
- (7) electric log (yes or no)
- (organization running log)
- (8) how well bottom plugged


CODED

AUG 22 1973

DRILLERS REMARKS:

If well telescopes please sketch and show depths.

GROUND LEVEL

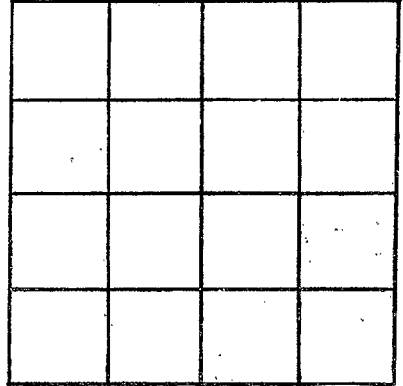

SECTION _____

Please indicate well location X.

ADDITIONAL INFORMATION

Lined area for recording additional information, consisting of 20 horizontal lines.

If more than one screen, show locations of each on sketch.