

GW-01658

Perpet 7/09

CODED

Tippah
 D-20
 Elev # 26
 94/01/80
 April 1 1980

MISSISSIPPI
 BOARD OF WATER COMMISSIONERS
 416 North State Street
 Jackson, Mississippi 39201

WATER WELL DRILLERS LOG

date well completed 1980 firm name T.M. Parks Drilling Co. county well located Tippah

LANDOWNER: Tippahsville
Water Assoc.
Tippah County, Ms.
 (mailing address)

WELL LOCATION:
 sec. 19 T 2 N R 4 E
2 miles SW of Walnut
 (distance) (direction) (nearest town)

description of formations encountered	from	to
Top soil	0	20
Sandy w/ clays	20	100
hard clays	100	120
Sandy clays w/ limestone	120	320
Sand w/ silts	320	380
Silty - sand gray formation	380	460
Firm limestone w/ clays	460	780
Good sand w/ fine shales	780	890

WELL PURPOSE: Community
 (home, irrigation, municipal, industrial)

WELL COMPLETION DATA:

(1) diameter (inches) 10"

(2) total depth (feet) 890'

(3) static water level (feet) _____ below/above top of ground.

(4) casing Steel 780
 (material) (depth)

10" if telescope see back.
 (size)

(5) screen 60' 830
 (length) (depth to top)
6" Stainless
 (size) (material)

(6) pump 40 250
 (HP) (yield gpm)

3 phase
 (type power)

(7) electric log Yes
 (yes or no)
MCS
 (organization running log)

(8) how well bottom plugged _____

DEPT. OF NATURAL RESOURCES
 BUREAU OF LAND & WATER RESOURCES


APR 30 1980

RECEIVED

DRILLERS REMARKS:

If well telescopes please
sketch and show depths.

GROUND LEVEL

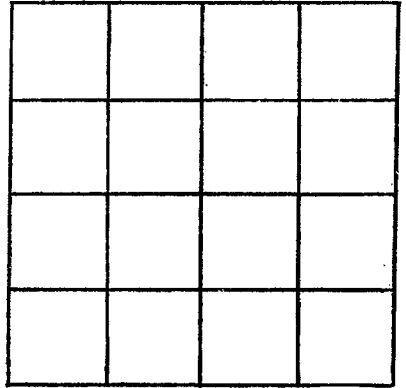

SECTION _____

Please indicate well location X.

ADDITIONAL INFORMATION

If more than one screen,
show locations of each on sketch.