

TIPPAN  
D 2000  
1-28-76

MISSISSIPPI  
BOARD OF WATER COMMISSIONERS  
416 North State Street  
Jackson, Mississippi 39201

WATER WELL DRILLERS LOG

1-28-76 1976 J. T. Medlin Tippah  
date well completed firm name county well located

LANDOWNER:  
MRS. J. T. Skinner  
R# 1 Tradersville  
(mailing address)

description of formations encountered from to  
Sand & Rock 0-100


WELL LOCATION:  
sec. 23 T<sub>2</sub> N R<sub>4</sub> E W  
4 mi East Tradersville  
(distance) (direction) (nearest town)

Blue dirt 60-120  
Sand & Shell 120-160

WELL PURPOSE: home  
(home, irrigation, municipal, industrial)

WELL COMPLETION DATA:  
(1) diameter (inches) 4 inch  
(2) total depth (feet) 160 ft  
(3) static water level (feet) 120 below top of ground.  
(4) casing Plastic, 100 (material) (depth)  
(size) if telescope see back.  
(5) screen (length) (depth to top)  
(size) (material)  
(6) pump 1/2 7-8 (HP) (yield gpm)  
Electric (type power)  
(7) electric log (yes or no)  
(organization running log)  
(8) how well bottom plugged


DRILLERS REMARKS:

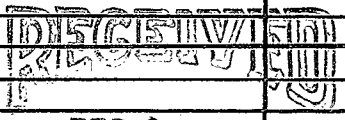

FEB 2 1976

If well telescopes please sketch and show depths.

GROUND LEVEL

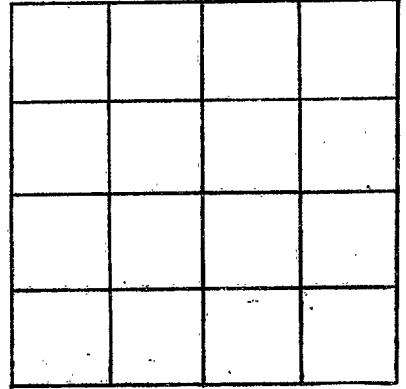

SECTION \_\_\_\_\_

Please indicate well location X.

ADDITIONAL INFORMATION

If more than one screen,  
show locations of each on sketch.