

Tippah
 D 200
 6-22-77

MISSISSIPPI
 BOARD OF WATER COMMISSIONERS
 416 North State Street
 Jackson, Mississippi 39201

WATER WELL DRILLERS LOG

June 22 1977 *16L* *77* *Billy R. Scarpson* *TIPPAAH*
 date well completed firm name county well located

LANDOWNER:
PAULINE GIBBS
 WALNUT, MISS
 (mailing address)

WELL LOCATION:
 sec. *6* T. *2* R. *4*
S *E*
2 1/2 miles *S* W of *WALNUT*
 (distance) (direction) (nearest town)

WELL PURPOSE:
 (home, irrigation, municipal, industrial)

description of formations encountered	from	to
SAND	0	18
SORPSTONE	18	22
Blue Clay & SAND	22	42
Blue Clay	42	66
Blue Clay & SAND	66	80
Blue Clay	80	110
ROCK & fine SAND	110	137
LIME STONE	137	147
Blue Clay	147	165
Limestone & Green Sand	165	189
ROCK	189	

WELL COMPLETION DATA:

(1) diameter (inches) *4*

(2) total depth (feet) *189*

(3) static water level (feet) *15* below/above top of ground.

(4) casing *POC* *110*
 (material) (depth)

(size) if telescope see back.

(5) screen *None*
 (length) (depth to top)

(size) (material)

(6) pump *1/2* *10*
 (HP) (yield gpm)

Elec
 (type power)

(7) electric log *No*
 (yes or no)

(organization running log)

(8) how well bottom plugged *None*


RECEIVED

NOV 11 1977

DRILLERS REMARKS:

If well telescopes please sketch and show depths.

GROUND LEVEL

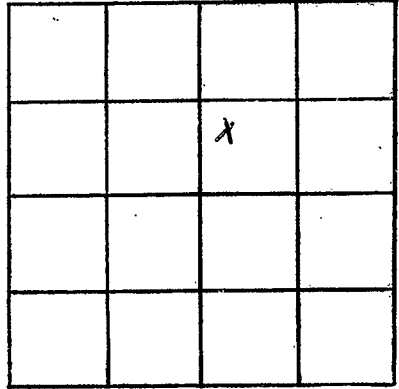

SECTION 6

Please indicate well location X.

ADDITIONAL INFORMATION

If more than one screen,
show locations of each on sketch.