

Tippah
 D 2003
 9-7-77

MISSISSIPPI
 BOARD OF WATER COMMISSIONERS
 416 North State Street
 Jackson, Mississippi 39201

Tippah

WATER WELL DRILLERS LOG

9-7
 date well completed

161 277 Medlin Wells
 firm name

~~Tippah~~
 county well located


LANDOWNER:	description of formations encountered	from	to
(mailing address)			
Zee Nails	Clay Sand + Rock	0	30
Walnut Miss.			
WELL LOCATION:			
sec. <u>1</u> T <u>2</u> N R <u>4</u> E			
<u>5</u> miles <u>East</u> of <u>Walnut</u>			
(distance) (direction) (nearest town)			
WELL PURPOSE: <u>Home</u>			
(home, irrigation, municipal, industrial)			
WELL COMPLETION DATA:			
(1) diameter (inches)	<u>4</u>		
(2) total depth (feet)	<u>145'</u>		
(3) static water level (feet)	<u>80'</u> below top of ground.		
(4) casing <u>PLAS.</u>	<u>145'</u>		
(material)	(depth)		
<u>10/3</u>	if telescope see back.		
(size)			
(5) screen <u>10'</u>	<u>135'</u>		
(length)	(depth to top)		
<u>4"</u>	<u>PLAS.</u>		
(size)	(material)		
(6) pump <u>1/2 sub</u>	<u>12</u>		
(HP)	(yield gpm)		
<u>Elec.</u>			
(type power)			
(7) electric log	<u>yes or no</u>		
(organization running log)			
(8) how well bottom plugged	<u>PLAS. CAP.</u>		
DRILLERS REMARKS:			

RECEIVED
 NOV 21 1977

MISS. BD. OF WATER COMMISSIONERS

If well telescopes please sketch and show depths.

GROUND LEVEL

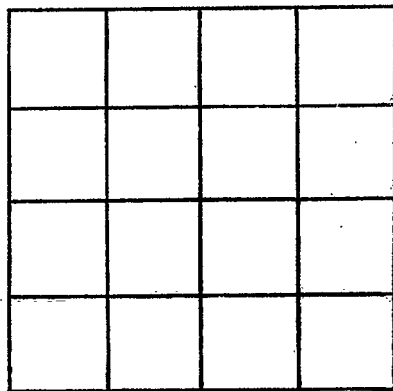

SECTION _____

Please indicate well location X.

ADDITIONAL INFORMATION

If more than one screen,
show locations of each on sketch.