

Tippah
 D 2003
 10-11-77

MISSISSIPPI
 BOARD OF WATER COMMISSIONERS
 416 North State Street
 Jackson, Mississippi 39201

WATER WELL DRILLERS LOG

10-11-77 date well completed
 16L T. BRYANT'S WELL DRILLING firm name
 Tippah county well located

LANDOWNER:
 Randall Brooks
 Walnut Ms.
 (mailing address)

description of formations encountered	from	to
Clay	0	30
Sand & Grack	30	105

WELL LOCATION:
 sec. 1 T 2 N R 4 E
 3 miles East of Chalchiate
 (distance) (direction) (nearest town)

WELL PURPOSE: home
 (home, irrigation, municipal, industrial)

WELL COMPLETION DATA:
 (1) diameter (inches) 4"
 (2) total depth (feet) 105'
 (3) static water level (feet) 70' below top of ground.
 (4) casing Pias 105' (material) (depth)
 1013 (size) If telescope see back.
 (5) screen 10' 95' (length) (depth to top)
 4" Pias (size) (material)
 (6) pump 1/2 HP 9 (HP) (yield gpm)
 (type power)
 (7) electric log (yes or no)
 (organization running log)
 (8) how well bottom plugged Pias cap


DRILLERS REMARKS:

RECEIVED
 NOV 21 1977

MISS. BD. OF WATER COMMISSIONERS

If well telescopes please sketch and show depths.

GROUND LEVEL

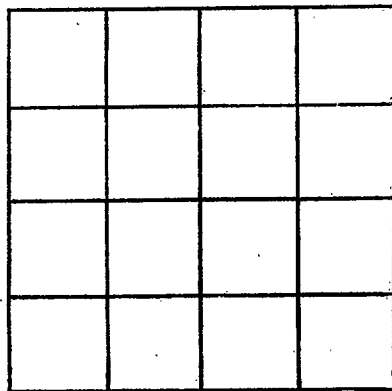

SECTION _____

Please indicate well location X.

ADDITIONAL INFORMATION

If more than one screen, show locations of each on sketch.