

TIPPAH
D 2005

MISSISSIPPI
BOARD OF WATER COMMISSIONERS
416 North State Street
Jackson, Mississippi 39201

WATER WELL DRILLERS LOG

5-20-78 19 Bygones Well Drilling Tippan
date well completed firm name county well located

LANDOWNER:	description of fomations encountered	from	to
Paul Denevy Ripley Miss (mailing address)			

WELL LOCATION:
sec. 1 T. 2 N. R. 4E ?
3 miles South of Falkner
(distance) (direction) (nearest town)

WELL PURPOSE: farm Diney beam
(home, irrigation, municipal, industrial)


- WELL COMPLETION DATA:
- (1) diameter (inches) 4
 - (2) total depth (feet) 180
 - (3) static water level (feet) 20 below top of ground.
 - (4) casing Plas, 100,
(material) (depth)
(size) if telescope see back.
 - (5) screen _____ (length) _____ (depth to top)
(size) _____ (material)
 - (6) pump 1/2 _____ 14
(HP) (yield gpm)
Elec
(type power)
 - (7) electric log _____ (yes or no)
(organization running log)
 - (8) how well bottom plugged Open

RECEIVED
AUG - 2 1978

DRILLERS REMARKS: _____
MISS. BD. OF WATER COMM

If well telescopes please
sketch and show depths.

GROUND LEVEL

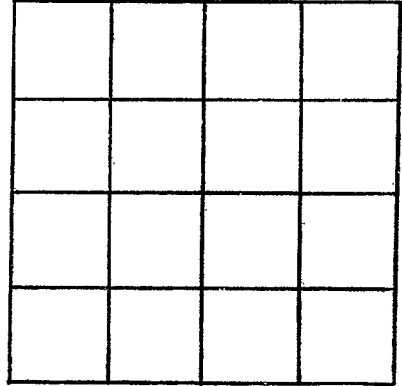

SECTION _____

Please indicate well location X.

ADDITIONAL INFORMATION

Lined area for additional information, consisting of approximately 20 horizontal lines.

If more than one screen,
show locations of each on sketch.