

TIPPAH

D

2008

9-20-78

MISSISSIPPI BOARD OF WATER COMMISSIONERS
416 North State Street
Jackson, Mississippi 39201

WATER WELL DRILLERS LOG

9-20

1978

date well completed

Wilson Well Co., Inc.
M. Brock

firm name

Tippan
county well located

LANDOWNER:

description of formations encountered

from

to

Nanny M. Brock

Rd 2 Walnut, Miss
(mailing address)

Top Soil 0 10
Blue Mud 10 100
Medinors White Sand 100 150

WELL LOCATION:

sec 28 2 N R 4 E
S W

? miles ? of ?
(distance) (direction) (nearest town)

WELL PURPOSE:

(home, irrigation, municipal, industrial)

WELL COMPLETION DATA:

- (1) diameter (inches) 4
- (2) total depth (feet) 150
- (3) static water level (feet) 70 below top of ground.
- (4) casing PVC 140 (material) (depth)
4 (size) if telescope see back.
- (5) screen 10 140 (length) (depth to top)
4 (size) gravel packed (material)
3/4
- (6) pump 2 10 (HP) (yield gpm)
electric (type power)
- (7) electric log (yes or no)

(organization running log)

(8) how well bottom plugged 4"
plastic cap


DRILLERS REMARKS:

RECEIVED
OCT 23 1978

MISS. Bd. OF WATER COMMISSIONERS

If well telescopes please sketch and show depths.

GROUND LEVEL

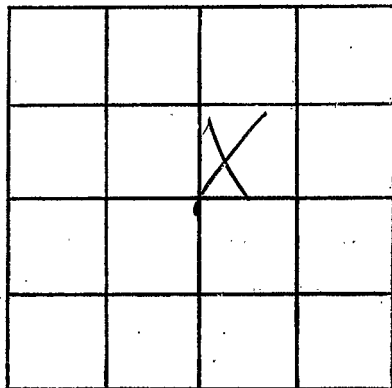

SECTION

28

Please indicate well location X.

ADDITIONAL INFORMATION

If more than one screen, show locations of each on sketch.