

TIPPAH

D 2007

9-19-78

MISSISSIPPI BOARD OF WATER COMMISSIONERS
416 North State Street
Jackson, Mississippi 39201

WATER WELL DRILLERS LOG

9-19-1978 date well completed

Wilson Well Co., Inc. firm name

Tipphah county well located

LANDOWNER:

Jerry Shearwright
Pt. 1 Suggersville Miss.
(mailing address)

description of formations encountered

from

to

Top Soil	0	15
Red Sand	15	60
Red Sand & Clay	60	100
Blue Clay	100	180
Green Coarse Sand	180	200

WELL LOCATION:

sec 28 T 2 N R 4 E
? miles ? of ?
(distance) (direction) (nearest town)

WELL PURPOSE:

(home, irrigation, municipal, industrial)


WELL COMPLETION DATA:

- (1) diameter (inches) 4
- (2) total depth (feet) 200
- (3) static water level (feet) 90 below top of ground.
- (4) casing PVC, 190 (material), 190 (depth)
4 (size) if telescope see back.
- (5) screen 10 (length), 190 (depth to top)
4 (size), gravel packed (material)
- (6) pump (HP) ~~Electric~~ (yield gpm)
- electric (type power)
- (7) electric log (yes or no)

(organization running log)

(8) how well bottom plugged 7"
Plastic cap


DRILLERS REMARKS:

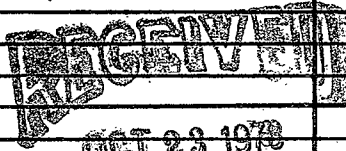

MISS. Bd. OF WATER COMMISSIONERS

If well telescopes please sketch and show depths.

GROUND LEVEL

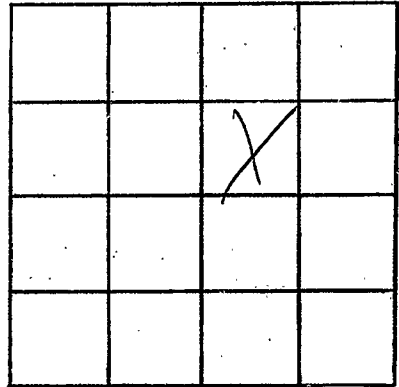

SECTION 28

Please indicate well location X.

ADDITIONAL INFORMATION

If more than one screen, show locations of each on sketch.