

TIPPAH

D 2008

10-15-78


MISSISSIPPI BOARD OF WATER COMMISSIONERS  
416 North State Street  
Jackson, Mississippi 39201

WATER WELL DRILLERS LOG

TIPPAH Co.

10-15-1978 date well completed      Robert W. Wilson firm name      Tippah Co. county well located


LANDOWNER:	description of formations encountered	from	to
Kenneth Mease ? Rt. 2 Box 168A Walnut Miss (mailing address)	Rock white clay + white sand	0	15
	white sand + green sand	15	30
	green sand & rock	30	45
	white sand & rock	45	60
	white sand & white clay	60	75
	white sand & white clay	75	90
	white sand & rock	90	105
	white sand & blue sand	105	120
	white sand & blue sand	120	123
WELL LOCATION: sec. 21 T. 2 N. R. 4 E. S. 5 W.			
(distance) miles (direction) of (nearest town)			
WELL PURPOSE: (home, irrigation, municipal, industrial)			
WELL COMPLETION DATA:			
(1) diameter (inches) 4			
(2) total depth (feet) 123			
(3) static water level (feet) 100 below top of ground.			
(4) casing (material) 4 (depth) 113			
4 (size) if telescope see back.			
(5) screen (length) 10 (depth to top) 113			
4 (size) gravel packed (material)			
(6) pump 1 (HP) 15 (yield gpm)			
electric (type power)			
(7) electric log (yes or no)			
(organization running log)			
(8) how well bottom plugged 4" plastic cap			
DRILLERS REMARKS:			

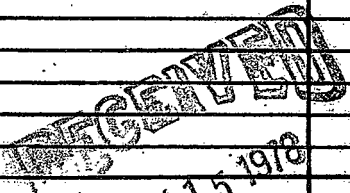

MISS. BD. OF WATER COMMISSIONERS

If well telescopes please sketch and show depths.

GROUND LEVEL

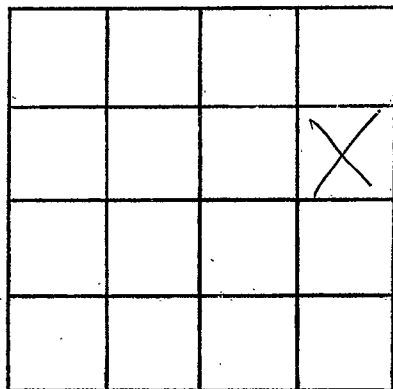

SECTION T25

Please indicate well location X.

ADDITIONAL INFORMATION

If more than one screen, show locations of each on sketch.