

MISSISSIPPI DEPARTMENT OF NATURAL RESOURCES
Bureau of Land and Water Resources
 Southport Mall
 P.O. Box 10631
 Jackson, Mississippi 39209
WATER WELL DRILLERS LOG

Tipphah
D 2011
7-7-80

July 7 1980 Webbwood Co. Tipphah
 date well completed firm name county well located

LANDOWNER:
John Bennett
Rt 1 Deplerville Mn
 (mailing address)

description of formations encountered	from	to
<u>Red clay + Red sand</u>	<u>0</u>	<u>30</u>
<u>Rock + Blue Clay</u>	<u>30</u>	<u>45</u>
<u>Rock, Blue clay</u>	<u>45</u>	<u>75</u>
<u>Blue Clay + Knob</u>	<u>75</u>	<u>90</u>
<u>Brown Sand + Rock</u>	<u>90</u>	<u>105</u>
<u>Blue Sand Rock</u>	<u>105</u>	<u>125</u>

WELL LOCATION:
 sec. 29 T. 2 N. R. 4 E. S. 3
4 miles South of Walnut
 (distance) (direction) (nearest town)

WELL PURPOSE:
 (home, irrigation, municipal, industrial)

WELL COMPLETION DATA:

(1) diameter (inches) 4

(2) total depth (feet) 125

(3) static water level (feet) 95 below above top of ground.

(4) casing PVC, 115,
 (material) (depth)

_____ if telescope see back.
 (size)

(5) screen 10, 115
 (length) (depth to top)

_____ , gravel packs
 (size) (material)

(6) pump 3/4 electric
 (HP) (yield gpm)

electric
 (type power)

(7) electric log _____
 (yes or no)


_____ (organization running log)

(8) how well bottom plugged 4"
plastic casing

DRILLERS REMARKS:

If well telescopes please sketch and show depths.

GROUND LEVEL

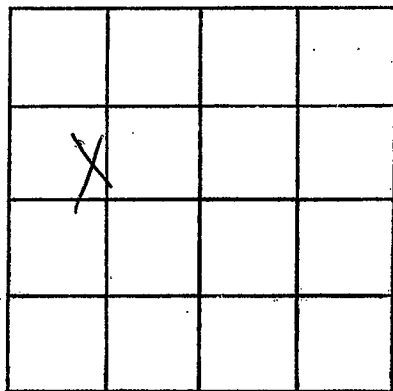

SECTION 29

Please indicate well location X.

ADDITIONAL INFORMATION

If more than one screen, show locations of each on sketch.