

MISSISSIPPI DEPARTMENT OF NATURAL RESOURCES
Bureau of Land and Water Resources
 Southport Mall
 P.O. Box 10631
 Jackson, Mississippi 39209
WATER WELL DRILLERS LOG

Tippah
D 2012
8-25-80

8-25 1980 Wilson Well Co Tippah
 date well completed firm name county well located

LANDOWNER:
Eva Robertson
Rt 1 Ospreyville, Miss
 (mailing address)

WELL LOCATION:
 sec. 17 T. 2 N R. 4 E
5 miles NE of Faulton
 (distance) (direction) (nearest town)

description of formations encountered	from	to
<u>Red Clay + Red Sand</u>	<u>0</u>	<u>30</u>
<u>Red Sand, Rock</u>	<u>30</u>	<u>60</u>
<u>Red Sand, Rock</u>	<u>60</u>	<u>90</u>
<u>Red Sand, Rock</u>	<u>90</u>	<u>105</u>
<u>Red Sand, Blue clay</u>	<u>105</u>	<u>120</u>
<u>Blue clay, Grey Sand</u>	<u>120</u>	<u>135</u>
<u>Grey Sand</u>	<u>135</u>	<u>153</u>

WELL PURPOSE:
 (home, irrigation, municipal, industrial)

WELL COMPLETION DATA:

(1) diameter (inches) 4

(2) total depth (feet) 153

(3) static water level (feet) 90 below above top of ground.

(4) casing pvc 153
 (material) (depth)
 (size) If telescope see back.

(5) screen 10 143
 (length) (depth to top)
 (size) ground rock (material)

(6) pump 3/4 electric
 (HP) (yield gpm)
electric
 (type power)

(7) electric log (yes or no) _____
 (organization running log) _____


(8) how well bottom plugged 4"
plastic cap

DRILLERS REMARKS:

DEPT. OF NATURAL RESOURCES
 BUREAU OF LAND & WATER RESOURCES
 RECEIVED
 SEP 29 1980

If well telescopes please sketch and show depths.

GROUND LEVEL

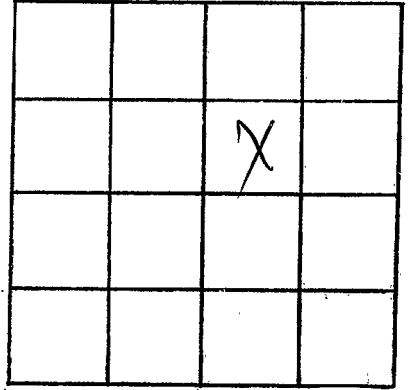

SECTION 17

Please indicate well location X.

ADDITIONAL INFORMATION

If more than one screen, show locations of each on sketch.