

Tippah
Benton
D 2013
5-21-81

MISSISSIPPI DEPARTMENT OF NATURAL RESOURCES
Bureau of Land and Water Resources
Southport Mall
P.O. Box 10631
Jackson, Mississippi 39209
WATER WELL DRILLERS LOG

May 24, 1981 date well completed
Wilson Well Co firm name
Benton county well located


LANDOWNER:
Danny Miller
1st
Tiptonville Ms 38674
(mailing address)

description of formations encountered	from	to
Red clay - Red sand	0	30
Red sand - Rock	30	60
Blue clay	60	90
Red sand	90	105
Rock - Blue clay	105	120
Blue clay - Rock	120	135
Blue clay - Rock	135	150
Brown sand	150	165
Brown sand	165	175

WELL LOCATION:
sec 24 T-2 N R-4 E
4.2 miles (distance) of Tiptonville (nearest town)

WELL PURPOSE: Home
(home, irrigation, municipal, industrial)


- WELL COMPLETION DATA:
- (1) diameter (inches) 4
 - (2) total depth (feet) 170'
 - (3) static water level (feet) 130 below top of ground.
 - (4) casing Plastic (material), (depth)
 - 4 (size) if telescope see back.
 - (5) screen 10 (length), (depth to top)
 - 4 Plastic (size), (material)
 - (6) pump (HP) (yield gpm)
 - electric (type power)
 - (7) electric log NO (yes or no)
 - (organization running log)
 - (8) how well bottom plugged Plastic Cap 4"

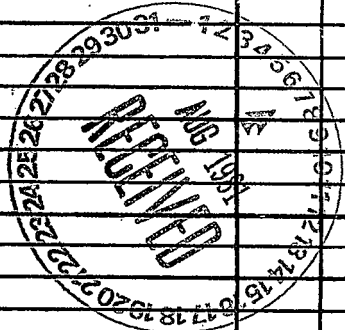

DRILLERS REMARKS:

If well telescopes please sketch and show depths.

GROUND LEVEL

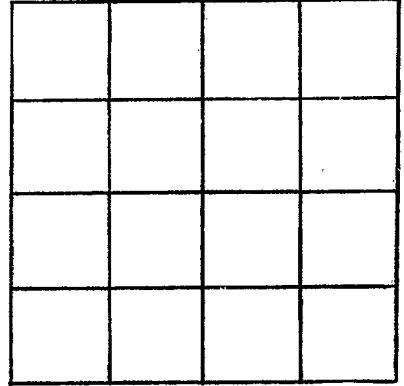

SECTION _____

Please indicate well location X.

ADDITIONAL INFORMATION

If more than one screen,
show locations of each on sketch.