

MISSISSIPPI DEPARTMENT OF NATURAL RESOURCES

Bureau of Land and Water Resources

Southport Mall

P.O. Box 10631

Jackson, Mississippi 39209

WATER WELL DRILLERS LOG

Tippah  
D 2014

3-5-82 19 19  
date well completed

Wilson Well Co  
firm name

Tippah  
county well located

LANDOWNER:  
Frank Smith  
Rt 1 Box 278  
Tiptonville, Miss  
(mailing address)

description of formations encountered	from	to
<u>Red clay - Red Sand</u>	<u>0</u>	<u>30</u>
<u>Red Sand - Rock</u>	<u>30</u>	<u>60</u>
<u>Blue Clay</u>	<u>60</u>	<u>90</u>
<u>Rock Blue Clay, Brn Sand</u>	<u>90</u>	<u>105</u>
<u>BROWN SAND</u>	<u>105</u>	<u>130</u>

WELL LOCATION:  
sec 22 T 2 N R 40  
S miles E of Tiptonville  
(distance) (direction) (nearest town)

WELL PURPOSE: Home  
(home, irrigation, municipal, industrial)

- WELL COMPLETION DATA:
- (1) diameter (inches) 4
  - (2) total depth (feet) 130
  - (3) static water level (feet) 120 below top of ground.
  - (4) casing Plastic, 120,  
(material) (depth)  
4 if telescope see back.  
(size)
  - (5) screen 10 (length) (depth to top)  
4 Plastic  
(size) (material)
  - (6) pump 1 (HP) 11 (yield gpm)  
electric (type power)
  - (7) electric log NO (yes or no)

(organization running log)  
(8) how well bottom plugged Plastic Cap 44

DRILLERS REMARKS:


DEPT. OF NATURAL RESOURCES  
BUREAU OF LAND & WATER RESOURCES

APR 21 1982

RECEIVED

If well telescopes please sketch and show depths.

GROUND LEVEL

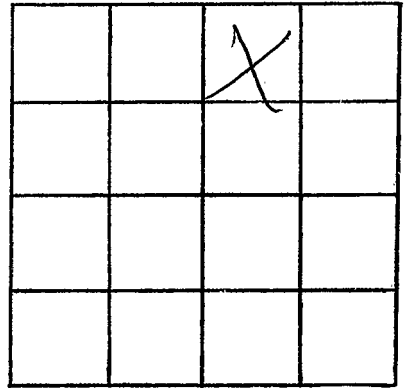

SECTION 22 -

Please indicate well location X.

ADDITIONAL INFORMATION

If more than one screen,  
show locations of each on sketch.