

MISSISSIPPI DEPARTMENT OF NATURAL RESOURCES

Bureau of Land and Water Resources

Southport Mall

P.O. Box 10631

Jackson, Mississippi 39209

WATER WELL DRILLERS LOG

TIPPAN
D 2015

10-26-86
date well completed

19 Medlin Well Drilling
firm name

Tippah
county well located

LANDOWNER:
Eddie Bennett
Joules MS
(mailing address)

description of formations encountered	from	to
Top Soil	0-	200
Sand & Grk		
Sand & Aquifer	200-	360

WELL LOCATION:
sec. 1 T 2 N R 40 E
2 1/2 miles NE of Joules
(distance) (direction) (nearest town)

WELL PURPOSE:
(home, irrigation, municipal, industrial)

WELL COMPLETION DATA:

(1) diameter (inches) 4"

(2) total depth (feet) 360'

(3) static water level (feet) 180' ^{below} above top of ground.

(4) casing PVC, 360'
(material) (depth)

(size) If telescope see back.

(5) screen 20' 340'
(length) (depth to top)
4" PVC
(size) (material)

(6) pump 3/4 12
(HP) (yield gpm)
Electric
(type power)

(7) electric log _____
(yes or no)

(organization running log)

(8) how well bottom plugged _____

RECEIVED


DEC 15 1986

Department of Natural Resources
Bureau of Land & Water Resources

DRILLERS REMARKS:

If well telescopes please
sketch and show depths.

GROUND LEVEL

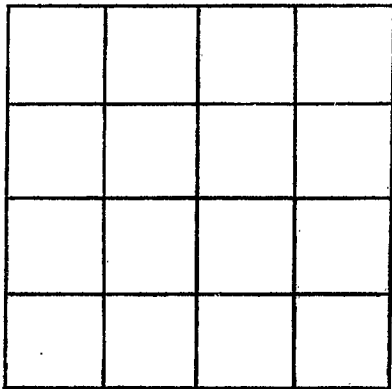

SECTION _____

Please indicate well location X.

ADDITIONAL INFORMATION

If more than one screen,
show locations of each on sketch.