

MISSISSIPPI DEPARTMENT OF NATURAL RESOURCES

Bureau of Land and Water Resources

Southport Mall

P.O. Box 10631

Jackson, Mississippi 39209

WATER WELL DRILLERS LOG

TIPPAH
ED
2017

11.2.1987
date well completed

Medlin Well
firm name

Tippah
county well located

LANDOWNER:
Carmelina Hopper
Tiplersville, MS.
(mailing address)

description of formations encountered	from	to
Soil & Rock	0	90
Rock & Aquifer	90	180

WELL LOCATION:
sec 17 T 2 N R 4 E
1 miles East of Tiplersville
(distance) (direction) (nearest town)

WELL PURPOSE:
(home, irrigation, municipal, industrial)

- WELL COMPLETION DATA:
- (1) diameter (inches) 4"
 - (2) total depth (feet) 180'
 - (3) static water level (feet) 100 ^{below} top of ground
 - (4) casing PVC, 180' (material) (depth)
(size) If telescope see back.
 - (5) screen (length) (depth to top)
(size) (material)
 - (6) pump 3/4 (material) 12 (HP) (yield gpm)
Electric (type power)
 - (7) electric log (yes or no)
(organization running log)
 - (8) how well bottom plugged


RECEIVED
SEP 28 1987

Department of Natural Resources
Bureau

DRILLERS REMARKS:

If well telescopes please
sketch and show depths.

GROUND LEVEL

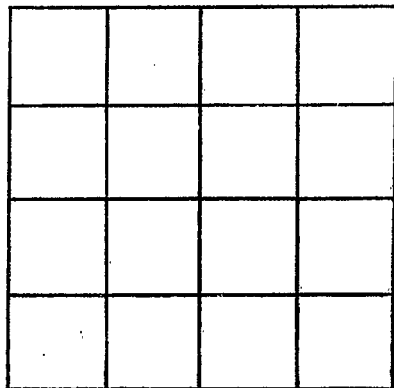

SECTION _____

Please indicate well location X.

ADDITIONAL INFORMATION

If more than one screen,
show locations of each on sketch.